


KANSAS

FORM 51 5M 11-44 PETROL

Section 2 Township 24 Range 15-W

Well No. #1 Doran

Company J. J. Lynn

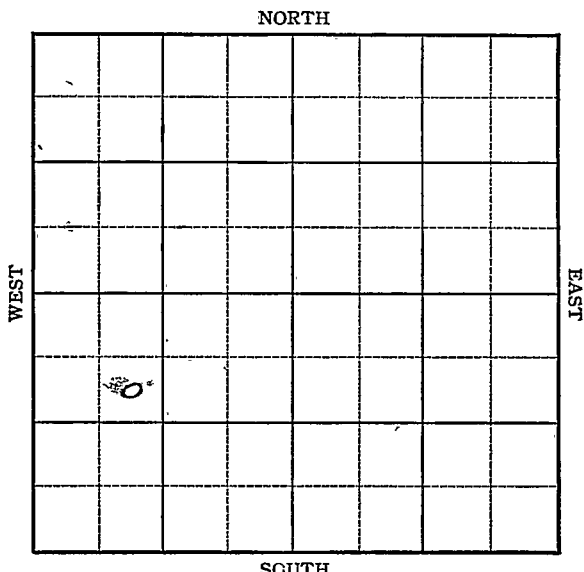

Sec. 2 Twp. 24 R. 15W

Well No. #1 Doran Farm

J. J. Lynn Company

Farmington


990 Ft. from N. Line

 Ft. from S. Line

 Ft. from E. Line

990 Ft. from W. Line

SE NW SW

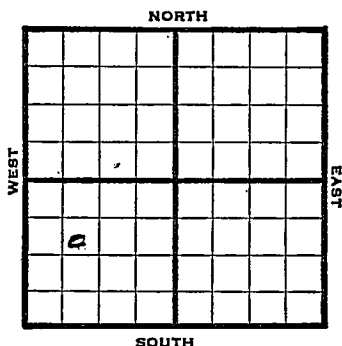

1946

REPORT

11/6

10" @ 255'
Drlg 2950'

11/13

Lans 3658'
Congl 3998'
Viola 4006'
Simp 4083'
Arb 4141'
TD 4172'

ABANDONED


Map No. 83 Sec. 2 Twp. 24 R. 15WWell No. 1 DoranJ. J. Lynn Company

FIRST REPORT

Contractor

SE NW SW

SECTION PLAT

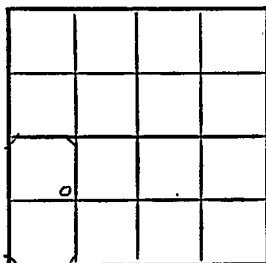990 Ft. from N. Line Ft. from S. Line Ft. from E. Line990 Ft. from W. Line

Stafford County

Location Rig up

Drilling and Remarks:

10" @ 255

drlg. 2950

RECORD

Cased in., ft.Sand Gas Oil Total Depth

PRODUCTION

1st 24 hrs. Nat. 1st 24 hrs. after shot Gas Cu. Ft.Dry Hole Abandoned

Date

NOV 6 1946 19 S. J. LEWIS Scout


Kansas

Map No. 83 Sec. 2 Twp. 24 R. 15WWell No. 1 DoranU. J. Lynn Company

ABANDONED

Contractor

SE NW SW

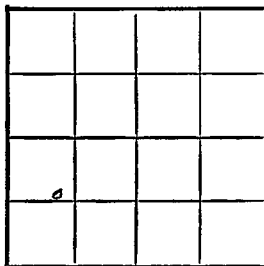E. No
SECTION PLAT990 Ft. from N. Line Ft. from S. Line Ft. from E. Line990 Ft. from W. Line

Stafford County

Location Rig up

Drilling and Remarks:


RECORD

Cased in., ft.Sand Gas Oil Total Depth 4172

PRODUCTION

1st 24 hrs. Nat. 1st 24 hrs. after shot Gas Cu. Ft.Dry Hole Abandoned

Date

NOV 13 1946 19

S. J. LEWIS

Scout