
FORM 51 25M 3-49 KANSAS Edwards

Section 2 Township 24 Range 16-W

Well No. #1 Klein

Company Max Cohen

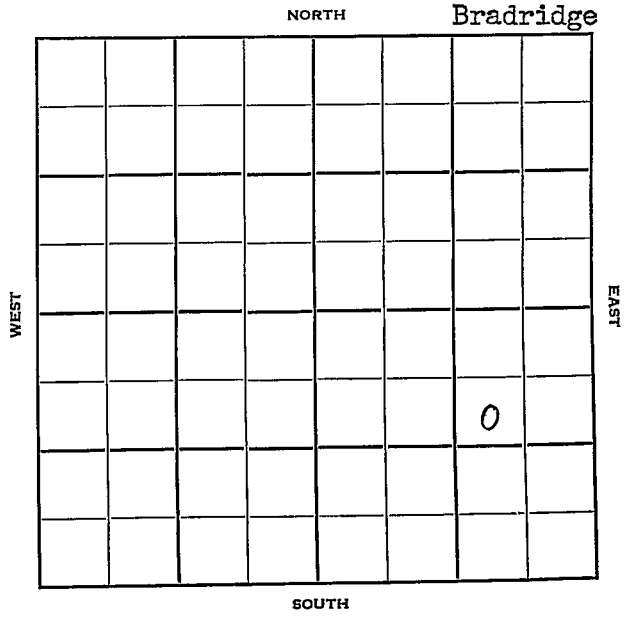

FORM 252-A
5M 10-48 PETROL

KANSAS

Edwards

Sec. 2 Twp. 24 R. 16W

Well No. 1 Klein Farm

Max Cohen Company

Brunson Contr. Bradridge Pool


990 Ft. from N. Line

Ft. from S. Line

990 Ft. from E. Line

Ft. from W. Line

SW NE SE

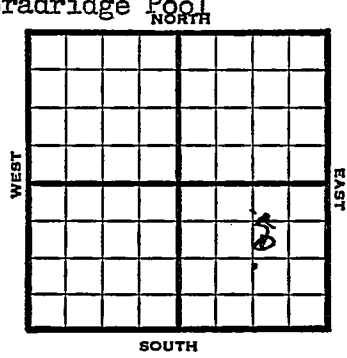

1949	Elev 2052' REPORT
7/27	8" @ 280 Anhy 948 3460
8/3	Lansing 3586' TD 3942 in Granite 5" @ 3805'
8/10	"
8/17	46 shots 3668-76 500 acid Swb 40 fluid PH 75% wtr
8/24	"
8/31	"
9/7	"
9/14	"
9/21	"
9/28	"
10/5	"
10/12	"
10/19	"
10/26	"
11/2	TD 3942' Lansing 3586' Granite Wash 3805' 5 @ 3805' Perf Lans 3000 acid 6 M Gas Comp COMPLETED

3942
2052
1890

3805
2052
1753

Form 26 200 Bks. 6-49 Petrol

Kansas Bradridge Pool

Map No. Sec. 2 Twp. 24 R. 16W

Well No. 1 Klein

Max Cohen Company

Brunson Contractor

FIRST REPORT

SECTION PLAT


SW NE SE

990 Ft. from N. Line

Ft. from S. Line

990 Ft. from E. Line

Ft. from W. Line

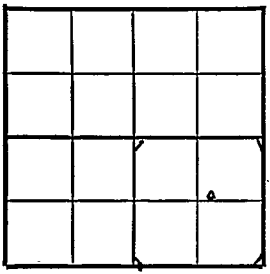

Edwards County

Location

Rig up

Drilling and Remarks:

8" @ 280'

anhy 948

3460

RECORD

Cased in ft.

Sand

Gas

Oil

Total Depth

PRODUCTION

1st 24 hrs. Nat.

1st 24 hrs. after shot

Gas Cu. Ft.

Dry Hole

Abandoned

Date

JUL 27 1949 19 S. J. LEWIS Scout

Form 26 200 Bks. 6-49 Petrol

Kansas

Bradridge Pool

Map No. _____ Sec. 2 Twp. 24 R. 16W

Well No. 1 Klein


Max Cohen Company

COMPLETE Contractor

SW NE SE

E 1, 2052.

SECTION PLAT

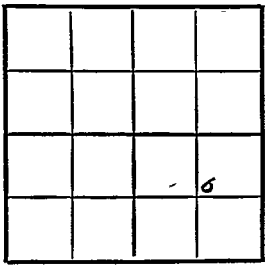

990 Ft. from N. Line

_____ Ft. from S. Line

990 Ft. from E. Line

_____ Ft. from W. Line

Edwards County

Location

Rig up

Drilling and Remarks:

Lane 3376
Granite 3725
5" @ 3805
Perforated
800 acid
60M Gas.

RECORD

Cased _____ in., _____ ft.

Sand

Gas

Oil

Total Depth 3942

PRODUCTION

1st 24 hrs. Nat.

1st 24 hrs. after shot

Gas _____ Cu. Ft.

Dry Hole

Abandoned

Date

NOV 2 1949 19

S. J. LEWIS Scout