


Section 2 Township 24 Range 16W

Well No. #2 Klein

Company Max Cohen

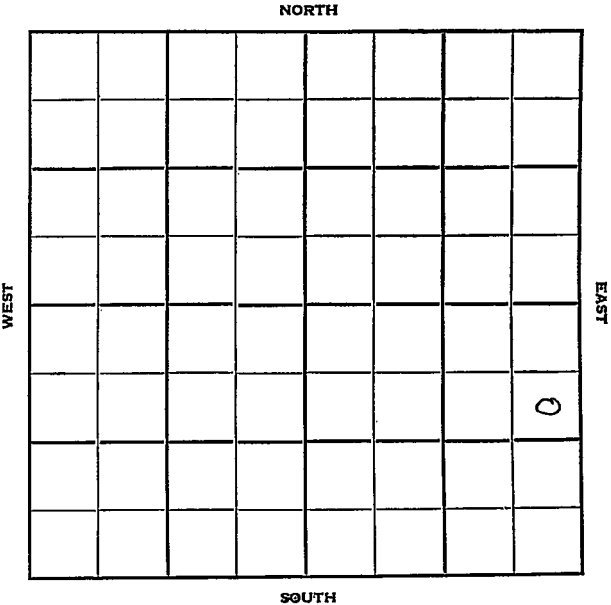

Sec. 2 Twp. 24 R. 16W

Well No. #2 Klein Farm

Max Cohen Company

Armer Contractor


990 Ft. from N. Line

 Ft. from S. Line

330 Ft. from E. Line

 Ft. from W. Line

SE NE SE

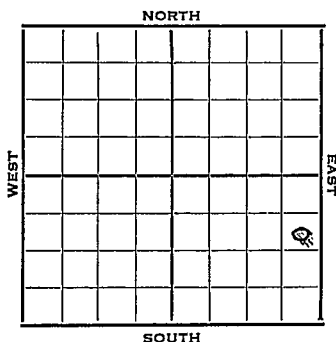

1952 Elev. 2057' REPORT

2/27 Spud 2-21-52
8" @ 310'
Drlg. 1890'

3/5 Drlg. 3475'

3/12 Heeb 3448 Tor 3465
Br Li 3574 KC 3584
DST 3652-60 1 hr. 95' HO&GCM 90'
oil 1245#
DST 3665-75 1 hr. 240' O&GCM
120' wtr 1105#
Granite 3955 RTD 3960
5" @ 3955' 3955
20'
1898

3/19 GO to 3962 TD 12/ 3950-62
little gas testing

3/25 PB 3828' 24/3735-43 24/3712-20
24/3652-60 1000 A Testing

4/1 S & F/4 BO plus A wtr. 4 hrs.


OVER

1952

4/9 Spud 2-21-52
Oil Well TD 3962
8" @ 310 Heeb. 3448
Tor. 3465 Br lime 3574
KC 3584
DST 3652-60 opn 1 hr. Rec. 95'
ho & gcm 90' oil
DST 3665-75 opn 1 hr. Rec. 240'
o & gcm 120' wtr Granite 3955
TD 3960 5" @ 3955 GO to 3962
12/3950-62 PB 3828
24/3735-43 24/3712-20 24/3652-60
1000 A Comp. F/50 bopd

COMPLETED

County Edwards State Kansas
 Sec. 2 (Blk. Twp.) 24 (Sur. Rge.) 16W Map No. _____
 Operator Max Cohen
 Well No. 2 Farm Klein
 Elev. 2057 Location SE NE SE

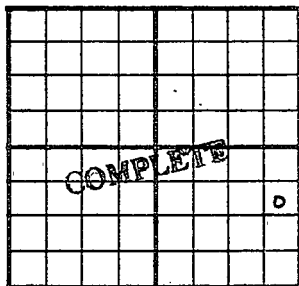

990 Ft. From N Line SE
330 Ft. From E Line Quarter
 Ist. Report _____
 Completion APR 9 1952
 Remarks _____
Armer - Contr.
 Spudding Date 2-21-52

Drilg. Data Oil well TD 3962
8" @ 310 Heeb. 3448 Tor. 3465
Br. lime 3574 KC 3584 DST 3652-60
open 1 hr. Rec. 95' ho & gcm 90' oil
DST 3665-75 open 1 hr. Rec. 240' o & gcm
120' water Granite 3955 TD 3960
5" @ 3955 CO to 3962 12/ 3950-62
PB 3828 24/ 3735-43 24/ 3712-20
24/ 3652-60 1000 A
Comp. F/ 50 bopd

J. G. McGEHEE