

Section 2 Township 24 Range 24W

Well No. #1 Schraeder "A"

Company Mid-States & Harbar

NORTH

0							

WEST

EAST

SOUTH

Hodgeman

KANSAS

24W

Sec. 2

Twp. 24

R.

Well No. #1 Schraeder "A" Farm

Mid-States & Harbar Company

Harbar Drlg. - Contr. Contractor

Wildcat


990' Ft. from N. Line

Ft. from S. Line

Ft. from E. Line

330' Ft. from W. Line

SW NW NW

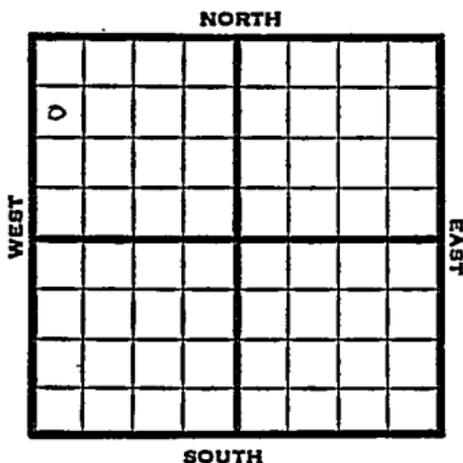

1951

Elev. 2469' REPORT

5/2


MIR

5/29

Spud 5-2-51
 D&A TD 5038
 10" @ 235
 Heeb. 3019
 Cong. 4729
 TD 5038 D&A

Lans. 4084
 Miss 4759'

ABANDONED

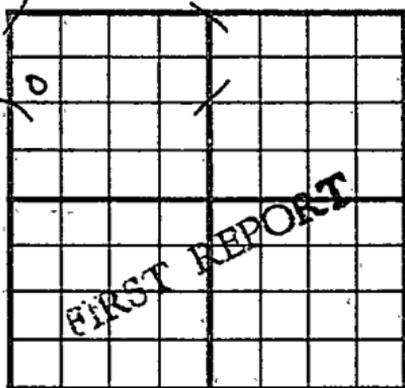County Hodgeman State KansasSec. 2 (Blk. Twp.) 24 (Sur. Rge.) 24W Map No.Operator Mid-States & HarbarWell No. 1 Farm Schraeder "A"Elev. _____ Location SW NW NW990 Ft. From N Line NW330 Ft. From W Line Quarter1st. Report MAY 2 1951

Completion _____

Remarks _____


Harbar Drlg. - Contr.

Spudding Date _____

Drlg. Data WildcatM I R

J. E. TYRA

County Hodgeman State Kansas
 Sec. 2 (Blk. 24) (Sur. 24W) Map No.
 Operator Mid-States & Harbar
 Well No. 1 Farm Schraeder "A"
 Elev. 2469 Location SW NW NW

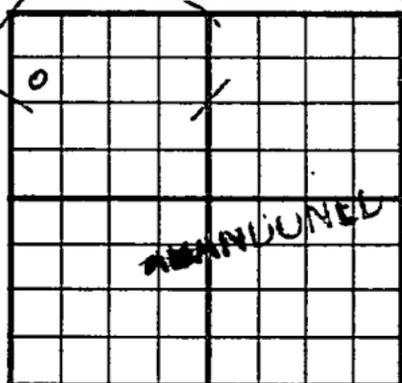

990 Ft. From N Line NW

330 Ft. From W Line Quarter

Ist. Report

Completion MAY 29 1951

Remarks Wildcat

Harbar Drlg. - Contr.

Spudding Date 5-2-51'

Drlg. Data D & A TD 5038

10" @ 235 Heeb. 4019 Lans. 4084

Cong. 4729 Miss. 4759 TD 5038

D & A