

Section 2 Township 24 Range 34WWell No. #1 JonesCompany Champlin Refg.

Hugoton Pool

NORTH

				0			

WEST

EAST

SOUTH

KANSAS

Finney

Sec. 2 Twp. 24 R. 34-W

Well No. #1 Jones Farm

Champlin Ref. Company

Champlin Ref. Contractor

Hugoton Pool


330 Ft. from N. Line

Ft. from S. Line

Ft. from E. Line

330 Ft. from W. Line

NW SE

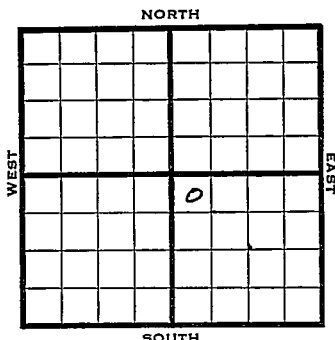

1949 Elev 2899' REPORT

11/9 Location

11/16 Drlg 200'

11/23 8" @ 653'

TD 2596'

7" @ 2596'

11/29 "

12/7 "

12/14 "

12/21 "

12/28 "

1950

3/8 TD 2596'

8" @ 653'

7" @ 2596'

Heeb 2402'

Cr 2432'

Win 2497'

16400000 CFGPD

Comp
COMPLETED

Map No. _____ Sec. 2 Twp. 24 R. 34W

Well No. 1 Jones

_____ Champlin Ref. _____ Company

_____ Champlin Ref. _____ Contractor

NW SE

**FIRST REPORT
SECTION PLAT**

330 Ft. from N. Line

_____ Ft. from S. Line

_____ Ft. from E. Line

330 Ft. from W. Line

		a	

Finney County

Location X

Rig up _____

Drilling and Remarks:

RECORD

Cased _____ in., _____ ft.

Sand _____

Gas _____

Oil _____

Total Depth _____

PRODUCTION

1st 24 hrs. Nat. _____

1st 24 hrs. after shot _____

Gas _____ Cu. Ft.

Dry Hole _____

Abandoned _____

Date

NOV 9 1949 19 S. J. LEWIS Scout

Kansas

Map No. _____ Sec. 2 Twp. 24 R. 34WWell No. 1 Jones

Champlin Ref.

Company


Contractor

NW SE

E1. 2899
SECTION PLAT330 Ft. from N. Line

_____ Ft. from S. Line

_____ Ft. from E. Line

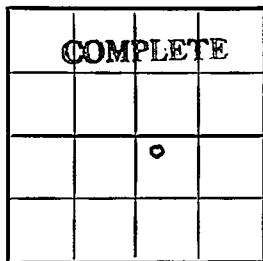330 Ft. from W. Line

Finney County

Location _____

Rig up _____

Drilling and Remarks:

8" @ 653

7" @ 2596

Hw 2402

Cr 2432

Win 2497

16400000

CFGPD

Date

MAR 8

1950 19

RECORD

Cased _____ in., _____ ft.

Sand _____

Gas _____

Oil _____

Total Depth _____

PRODUCTION

1st 24 hrs. Nat. _____

1st 24 hrs. after shot _____

Gas _____ Cu. Ft.

Dry Hole _____

Abandoned _____

J. E. TYRA

Scout