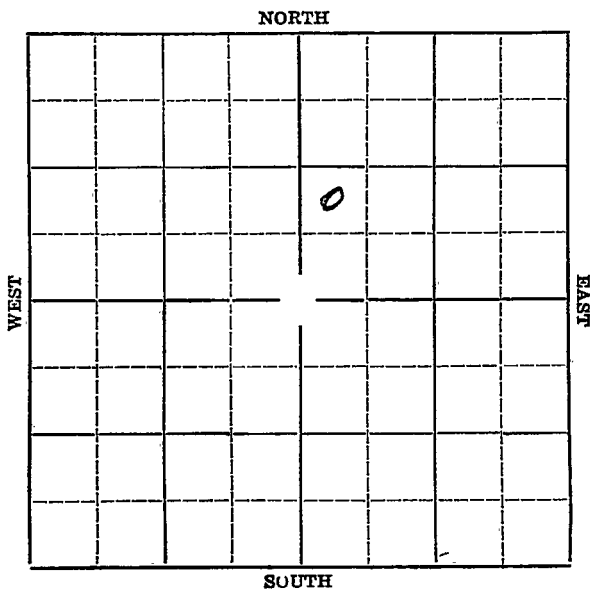


Section 20 Township 24 Range 4-WWell Number #3-MountCompany Houston

Reno

Map No. KANSAS Sec. 20 Twp. 24 R. 4W

Well No. #3 Mount Farm
Houston Company


 Ft. from N. Line

990' Ft. from S. Line

 Ft. from E. Line

330' Ft. from W. Line

Elev. 1471

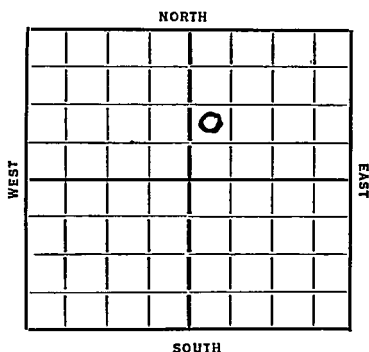

Date
1936

REPORT

7/1 Rig.

7/9 Drlg. 478'.

7/16 Spud.

7/23 Drlg. 2745'.

7/30 Chat ~~3325'~~ 7" @ 3335'.
3332'

8/6 (3332'. Chat.) CORRECTED. C.O.

8/13 Total depth 3382'. Shot 30 qts.
Clean out.

8/20 Swab 23 bbls of oil. 7 bbls of water
~~in~~ in 2 hours.

8/27 Flow 325 bbls of oil in 24 hours.

9/2/36 Chat 3332'. (CORRECTED)

T.D. 3382'.

Shot 30 qts.

2000 gallons of acid.

Flow 1671 bbls of oil

COMPLETED

KANSAS

Map No. 40 Sec. 20 Twp. 24 R. 4WWell No. 3 Moun XHouston Company

Contractor

SECTION PLAT

		0	

_____ Ft. from N. Line

990 Ft. from S. Line

_____ Ft. from E. Line

330 Ft. from W. Line

FIRST REPORT

Location _____

Rig up _____

Drilling and Remarks:

Rig

RECORD

Cased _____ in., _____ ft.

Sand _____

Gas _____

Oil _____

Total Depth _____

PRODUCTION

1st 24 hrs. Nat. _____

1st 24 hrs. after shot _____

Gas _____ Cu. Ft.

Dry Hole _____

Abandoned _____

Date

1933

19

S. J. LEWIS

Scout

KANSAS

Map No. 40 Sec. 20 Twp. 24 R. 4WWell No. 3 Alouin J.Houston Company

Contractor

SECTION PLAT

		0	
		1	

 Ft. from N. Line990 Ft. from S. Line Ft. from E. Line330 Ft. from W. Line

COMPLETED

Location Rig up

Drilling and Remarks:

Ok 43332.
 corrected
 43309 to
 2000 acid
 Flow 167/88%

RECORD

Cased in., ft.Sand Gas Oil Total Depth 3382

PRODUCTION

1st 24 hrs. Nat. 1st 24 hrs. after shot Gas Cu. Ft.Dry Hole Abandoned

Date

SEP 2 1936

19

S. J. LEWIS Scout