


Section 20 Township 24 Range 4-W

Well Number 3-Scheutzer

Company Empire

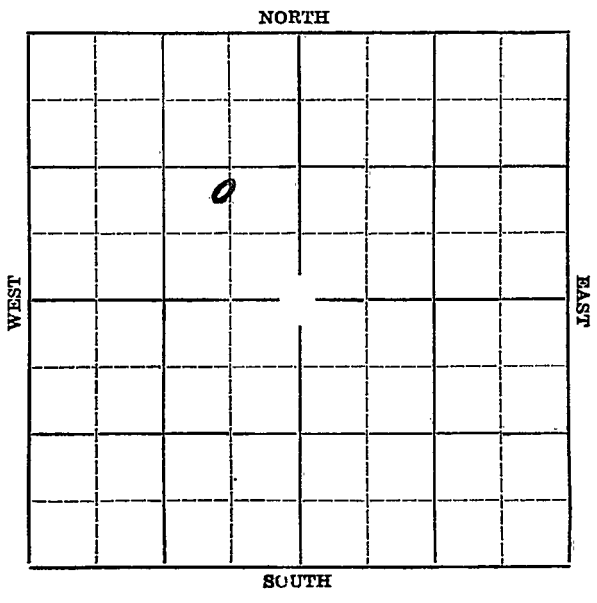

Map No. KANSAS Sec. 20 Twp. 24 R. 4W

Well No. #3 Scheutzer Farm

Empire Company


_____ Ft. from N. Line

990' Ft. from S. Line

668' Ft. from E. Line

_____ Ft. from W. Line

Elev. 1468

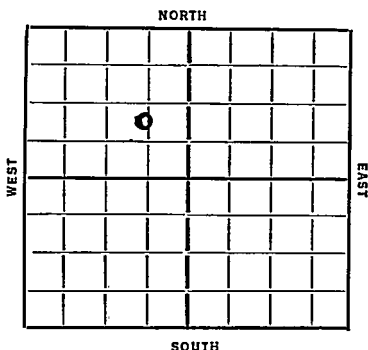

Date 1936

REPORT

7/1 Location

7/9 Rig.

7/16 Spud.

7/23 Drlg. 650' /

7/30 Drlg. 2674'.

8/6 Chat 3331'. 8" @ 3338'. TD 3339'.

Rigging up standard tools.

8/13 T.D. 3372'. 200' water. 1/5th of a million cubic feet of gas.

Plug back.

8/20 Shut down.

8/26/36-Chat 3331'.

T.D. 3372'.

Plug back to 3363'.

4000 gallons of acid.

659 bbls of oil and 61 bbls of water.

COMPLETED

Map No. 40 Sec. 20 Twp. 24 R. 4W

Well No. 3 Schautzer

Empire Company

Contractor

SECTION PLAT

	o		

_____ Ft. from N. Line

990 Ft. from S. Line

668 Ft. from E. Line

_____ Ft. from W. Line

FIRST REPORT

Location ✓

Rig up _____

Drilling and Remarks:

RECORD

Cased _____ in., _____ ft.

Sand _____

Gas _____

Oil _____

Total Depth _____

PRODUCTION

1st 24 hrs. Nat. _____

1st 24 hrs. after shot _____

Gas _____ Cu. Ft.

Dry Hole _____

Abandoned _____

Date

JUL 1 1936

19

LEWIS

Scout

KANSAS

Map No. 40 Sec. 20 Twp. 24 R. 4W

Well No. 3 Schuetzger

Empire Company

Contractor

SECTION PLAT

	0		

_____ Ft. from N. Line

990 Ft. from S. Line

668 Ft. from E. Line

_____ Ft. from W. Line

COMPLETED

Location _____

Rig up _____

Drilling and Remarks:

Cha 83331

PA 3363

4000 acid

659 oil

61 water

RECORD

Cased _____ in., _____ ft.

Sand _____

Gas _____

Oil _____

Total Depth 3,372

PRODUCTION

1st 24 hrs. Nat. _____

1st 24 hrs. after shot _____

Gas _____ Cu. Ft.

Dry Hole _____

Abandoned _____

Date

AUG 26 1936 19

S. J. LEWIS Scout