

KANSAS


Reno

Form 51-5M-4-36-Palace

Section 20 Township 24 Range 4-W

Well Number 2-Scheutzer

Company Empire

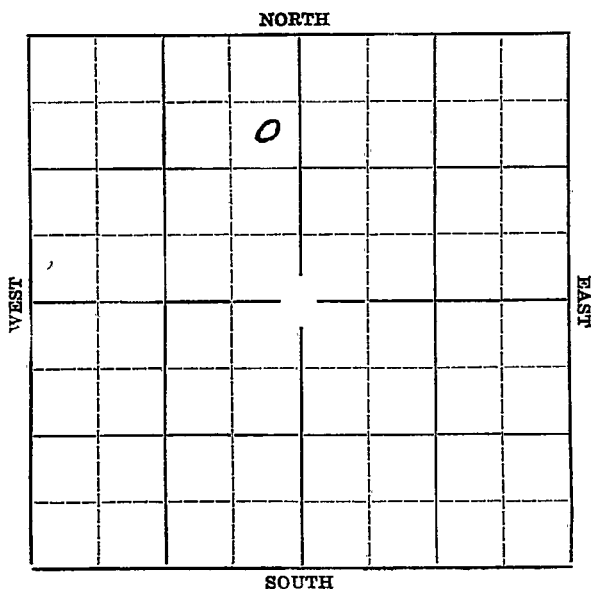

O. W. D. D

Reno

Map No. KANSAS Sec. 20 Twp. 24 R. 4WWell No. #2 Scheutzer FarmEmpire

Company

NORTH

WEST

EAST

SOUTH

990' Ft. from N. Line Ft. from S. Line330' Ft. from E. Line Ft. from W. Line

Elev. 1468

Date
1936

REPORT

O. W. D. D6/17 Location6/25 Building rig.7/2 15" @ 197'. Waiting on cement.7/9 Drlg. 1020'.7/16 Drlg. 2905'.7/23 Chat 3320'. 8" @ 3326'.7/30 T.D. 3379'. Run tubing.8/6 Estimate 250 bbls natural. 4000
gallons of acid. No test.8/12/36 Chat 3333'.

T.D. 3379'.

4000 gallons of acid.

Flow 560 bbls of oil and 50 bbls
of water.

COMPLETED

OVER

O.W.D.D

1937

5/19 O.T.D. 3379'.

T.D. 3392'.

Pumped 241 oil & 174 water.

Acidize 2000²⁴.

Pot. 481 oil & 170 water.

FIRST REPORT

and

COMPLETED

W 1 2 3

Map No. KANSAS Sec. 20 Twp. 24 R. 4 W

Well No. 2 Schreutger

Empire Company

Contractor

SECTION PLAT

990 Ft. from N. Line

_____ Ft. from S. Line

330 Ft. from E. Line

_____ Ft. from W. Line

FIRST REPORT

Location ✓

Rig up _____

Drilling and Remarks:

RECORD

Cased _____ in., _____ ft.

Sand _____

Gas _____

Oil _____

Total Depth _____

PRODUCTION

1st 24 hrs. Nat. _____

1st 24 hrs. after shot _____

Gas _____ Cu. Ft.

Dry Hole _____

Abandoned _____

Date

JUN 17 1936

S. J. LEWIS Scout

KANSAS

Map No. 40 Sec. 20 Twp. 24 R. 4WWell No. 2 SchenckesEmpire Company

Contractor

SECTION PLAT

	0		

990 Ft. from N. Line

_____ Ft. from S. Line

330 Ft. from E. Line

_____ Ft. from W. Line

COMPLETED

Location _____

Rig up _____

Drilling and Remarks:

@ha 8 33334000 acidFlow 560886oil 50886 water

RECORD

Cased _____ in., _____ ft.

Sand _____

Gas _____

Oil _____

Total Depth 3329

PRODUCTION

1st 24 hrs. Nat. _____

1st 24 hrs. after shot _____

Gas _____ Cu. Ft.

Dry Hole _____

Abandoned _____

Date

AUG 12 1936

19

S. J. LEWIS

Scout

Map No. 40 Sec. 20 Twp. 24 R. 4WWell No. 2 - SchentzerEmpire Company**FIRST REPORT** Contractor✓
COMPLETED**SECTION PLAT**

	0		

990 Ft. from N. Line

_____ Ft. from S. Line

330 Ft. from E. Line

_____ Ft. from W. Line

Q.W.D.D.

Location _____

Rig up _____

Drilling and Remarks:

O.T.D. 3379T.D. - 3392Pumped 241 oil
174 wat2000 AcidPat - 481 oil + 170 wat**RECORD**

Cased _____ in., _____ ft.

Sand _____

Gas _____

Oil _____

Total Depth _____

PRODUCTION

1st 24 hrs. Nat. _____

1st 24 hrs. after shot _____

Gas _____ Cu. Ft.

Dry Hole _____

Abandoned _____

Date

MAY 19 1937 19H. D. Hatfield

Scout