

KANSAS


FORM 51 5M 1-42 PETROL

Stafford

Section 20 Township 24 Range 13-W

Well No. #1 Van Lieu "B"

Company Stanolind & Derby

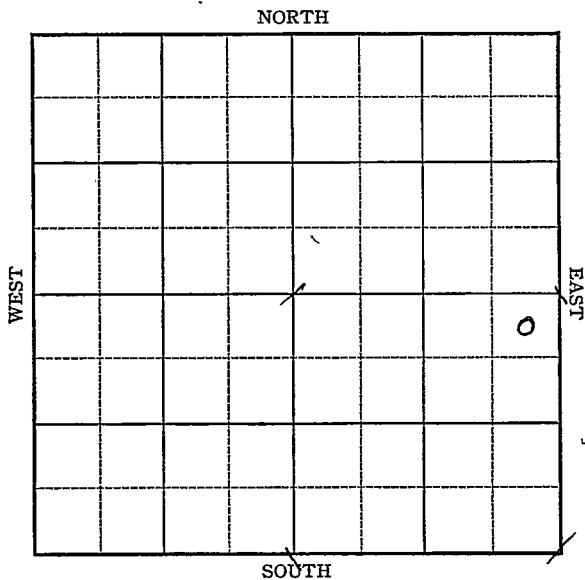

KANSAS

Stafford

Sec. 20 Twp. 24 R. 13-W

Well No. #1 Van Lieu "B" Farm

Stanolind & Derby Company

Van Lieu


330 Ft. from N. Line

 Ft. from S. Line

330 Ft. from E. Line

 Ft. from W. Line

elw. 1932

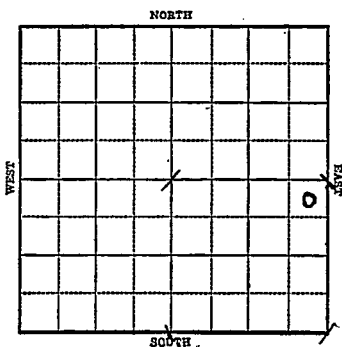

1943


R E P O R T

6/2 Derrick
6/9 Shut down
6/16 8" @ 276'
Drlg. 1900'
6/23 Andy 785
Drlg. 3640'
6/30 Lans 3595
Viola 4030
Arb. 4156
T.D. 4169'

ABANDONED

KANSASMap No. 8 Sec. 20 Twp. 24 R. 13WWell No. 1 Van Lieu "B"Stanolind & Derby Company**FIRST REPORT** Contractor

NE SE

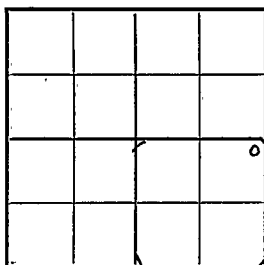SECTION PLAT330 Ft. from N. Line Ft. from S. Line330 Ft. from E. Line Ft. from W. Line**VAN LIEU POOL**Location Rig up

Drilling and Remarks:

Derrick**RECORD**Cased in., ft.Sand Gas Oil Total Depth **PRODUCTION**1st 24 hrs. Nat. 1st 24 hrs. after shot Gas Cu. Ft.Dry Hole Abandoned

Date

JUN 2 1943 19S. J. LEWIS Scout

KANSAS 3 Sec. 20 Twp. 24 R. 13WWell No. 1 Van Lieu "B"Stanolind & Derby CompanyABANDONED Contractor

NE SE

SECTION PLAT

330 Ft. from N. Line

Ft. from S. Line

330 Ft. from E. Line

Ft. from W. Line

VAN LIEU POOL

			o

Location _____

Rig up _____

Drilling and Remarks:

*Lane 3595**Vista 4030**Or 4156*

RECORD

Cased _____ in., _____ ft.

Sand _____

Gas _____

Oil _____

Total Depth 4169

PRODUCTION

1st 24 hrs. Nat. _____

1st 24 hrs. after shot _____

Gas _____ Cu. Ft.

Dry Hole _____

Abandoned _____

Date

JUN 30 1943 19

S. J. LEWIS Scout