


~~KANSAS~~

Section 20 Township 24 Range 14W

Well No. #1 Sewing

Company Lindas & Phillips
Wildcat

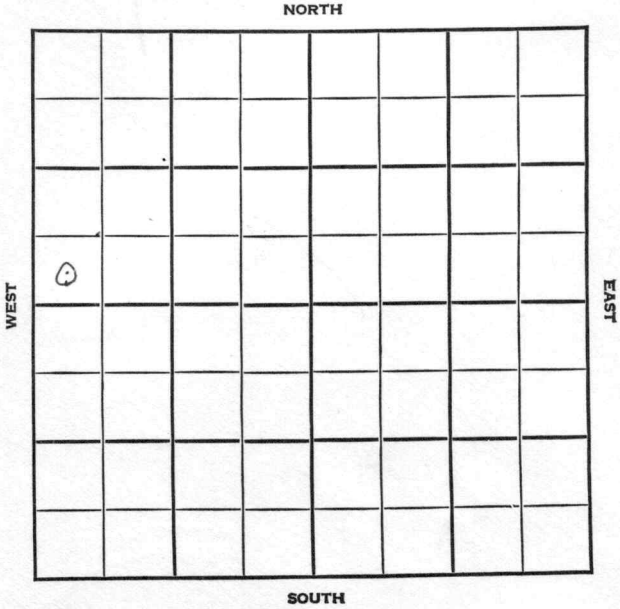

KANSAS

Stafford County

Sec. 20 Twp. 24 R. 14WWell No. #1 Sewing FarmLindas & Phillips Company

Wildcat


Ft. from N. Line

330 Ft. from S. Line

Ft. from E. Line

330 Ft. from W. Line

SW NW

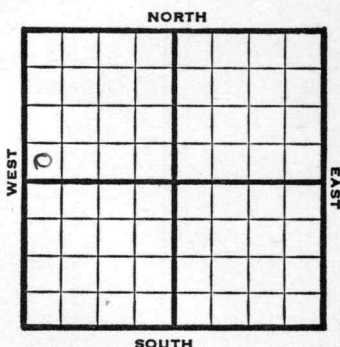

1948

Elv. 1990' REPORT

4/21

RUR

4/28

8" @ 458'
WOC

5/5

Lansing 3752'
Drlg.

5/12

Mississippi 4101'
Drlg. 4196'

5/19

Viola 4270'
Simp 7304'
Arbuckle 4310'
TD 4386'4310
1990
-2320

ABANDONED

Map No. 83 Sec. 20 Twp. 24 R. 14W

Well No. 1 Sewing

Lindas & Phillips Company

ABANDONED

Contractor

SW NW

E1.1990
SECTION PLAT

4			

 Ft. from N. Line

330 Ft. from S. Line

 Ft. from E. Line

330 Ft. from W. Line

Stafford County

Location

Rig up

Drilling and Remarks:

Vista 4270
Simp 4304
Or 44310

RECORD

Cased in., ft.

Sand

Gas

Oil

Total Depth 4386

PRODUCTION

1st 24 hrs. Nat.

1st 24 hrs. after shot

Gas Cu. Ft.

Dry Hole

Abandoned

Date

MAY 19 1948

19

S. J. LEWIS

Scout