


DX 78-1

Edwards KANSAS

Section 20 Township 24 Range 16W

Well No. 1 Nolan

Company Harms-Burt & Amerada Petr.

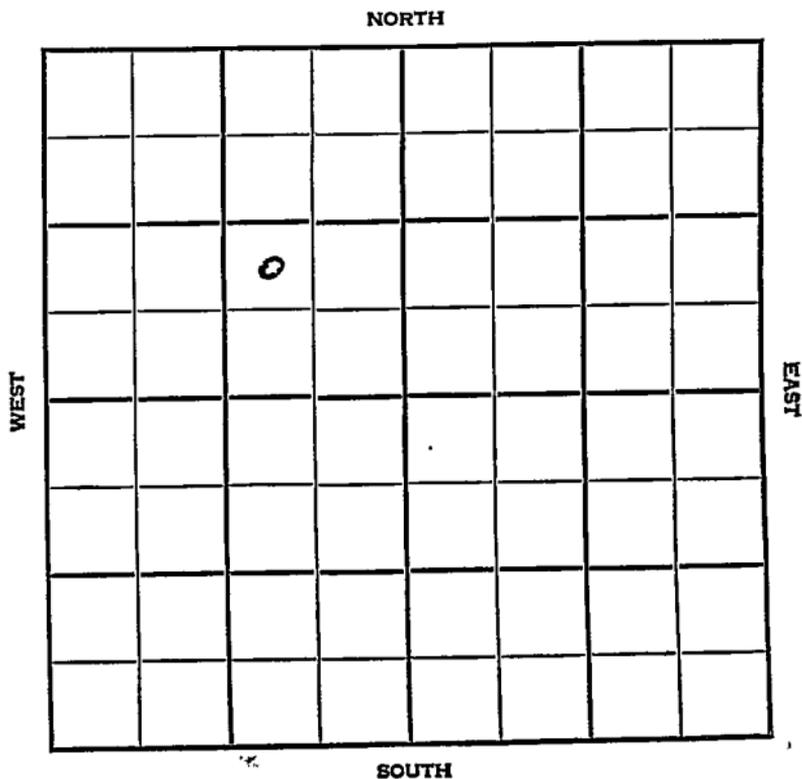

Edwards KANSAS

SEC.	TWP.	R.
20	24	16W

WELL NO. **1 Nolan** FARM

COMPANY **Harms-Burt & Amerada Petr.**

CONTRACTOR **Harms-Burt**


Wildcat

_____ Ft. from N. Line

990 _____ Ft. from S. Line

990 _____ Ft. from E. Line

_____ Ft. from W. Line

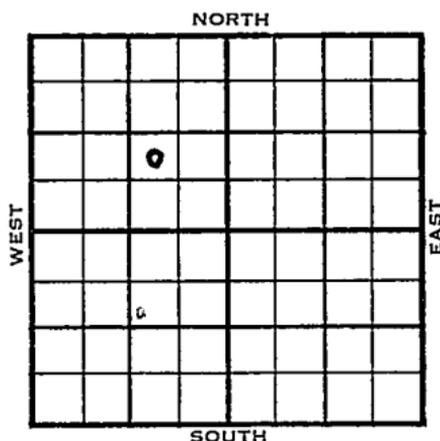

NW SE NW

	ELEVATION	REPORT
1954	2087'	

12/29 Spud 12-13-54
 8" @ 208'
 Heeb. 3696', Br. lime 3826', Lans. 3837'
 Drlg. 4046'

1955
 1/5 Spud 12-13-54 - D&A
 TD 4680'
 8" @ 208'
 Heeb. 3696', Br. lime 3826', Lans. 3837'
 Schl Tops: Heeb. 3692', Br lime 3823',
 Lans. 3838', Miss. 4269', Maq. 4359',
 Viola 4389', Simp. 4596', Arb. 4666'
 TD 4680'
 D&A

ABANDONED


County Edwards State KANSAS

Sec. 20 (Blk. Twp.) 24 (Sur. Rge.) 16W Map No.

Operator Harms-Burt & Amerada, Pet.

Well No. 1 Farm Nolan

Elev. 2087 Location NW SE NW

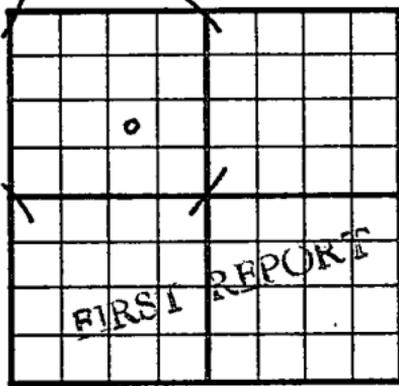

990 Ft. From S Line NW

990 Ft. From E Line Quarter

Ist. Report DEC 29 1954

Completion _____

Remarks _____

Harms-Burt - Contr.

Spudding Date 12-13-54

Drlg. Data Wildcat

8" @ 208 Heeb. 3696 Br. line 3826

Lans. 3837 drlg. 4046

FABEN GILSTRAP

County Edwards State Kansas

Sec. 20 (Bk.) 24 (Sur.) 16W Map No. (Twp.) (Rge.)

Operator Harms-Burt & Amerada Pet.

Well No. 1 Farm Nolan

Elev. 2087 Location NW SE NW

ABANDONED

990 Ft. From S Line NW

990 Ft. From E Line Quarter

Ist. Report

Completion JAN 5 1955

Remarks Wildcat

Harms-Burt - Contr.

Spudding Date 12-13-54

Drig. Data D & A TD 4680

8" @ 208 Heeb. 3696 Br. lime 3826

Lans. 3837 SCHLUMBERGER TOPS:

Heeb. 3692 Br. lime 3823 Lans. 3838

Miss. 4269 Mag. 4359 Viola 4389

Simp. 4596 Arb. 4666 TD 4680

D & A

$$\begin{array}{r} 4666 \\ 2087 \\ \hline 2579 \end{array}$$

FADEN GILSTRAP