

KANSAS


FORM 51 5M 6-46 PETROL

Kearny county

Section 20 Township 24 Range 35-W

Well No. #1, Walters etal

Company Fin-Ker

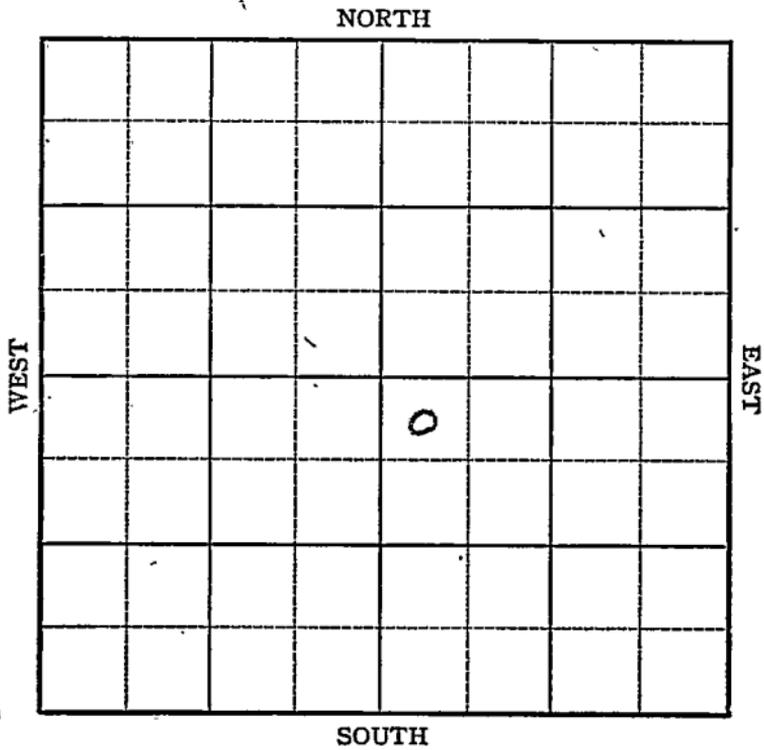



Sec. 20 Twp. 24 R. 35W

Well No. #1 Walters et al Farm

Kin-Ker Company


Hugoton Pool

328 Ft. from N. Line

Ft. from S. Line

250 Ft. from E. Line

Ft. from W. Line

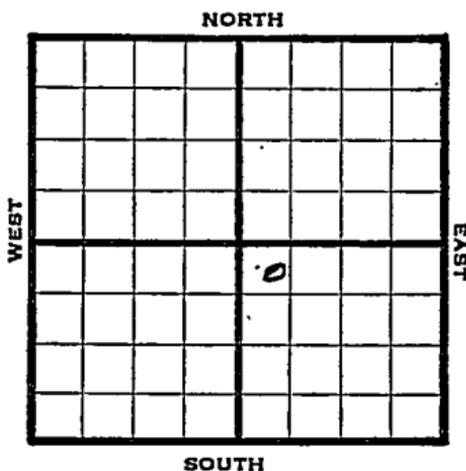

NW SE

1946 Elev. 2969' REPORT

10/23	Drlg 900'	
10/29	10" @ 1571'	
	Drlg 2100'	
11/6	" "	
11/12	TD 2700'	
	7" @ 2692, RUST	
11/20	" "	" "
11/27	" "	" "
12/3	" "	" "
12/10	" "	" "
12/17	" "	" "
1947		
1/4	TD 2700'	
	7" @ 2592, RUST	
1/8	" "	" "
1/15	" "	" "
1/21	" "	" "
1/30	" "	" "
2/5	" "	" "
2/12	" "	" "

OVER

2/19 TD 2700'
7" @ 2592'
RUST

2/26 TD 2700'
7" @ 2692'
Perf
65,000 Acid
3,073,000 Gas
397# R Pr

COMPLETED

Kansas

Map No. _____ Sec. 20 Twp. 24 R. 35W

Well No. 1 Walters etal.

Fin-Ker _____ Company

FIRST REPORT

Contractor _____

NW SE

SECTION PLAT

328 Ft. from N. Line

_____ Ft. from S. Line

250 Ft. from E. Line

_____ Ft. from W. Line

		0	

Keamy County

Location _____

Rig up _____

Drilling and Remarks:

drlg. 900'

RECORD

Cased _____ in., _____ ft.

Sand _____

Gas _____

Oil _____

Total Depth _____

PRODUCTION

1st 24 hrs. Nat. _____

1st 24 hrs. after shot _____

Gas _____ Cu. Ft.

Dry Hole _____

Abandoned _____

Date

OCT 23 1946 19

S. J. LEWIS

-Scout

Map No. _____ Sec. 20 Twp. 24 R. 35WWell No. 1 Walters etal.

Fin-Ker _____ Company

COMPLETE

Contractor

NW SE

E12969
SECTION PLAT328 Ft. from N. Line

_____ Ft. from S. Line

250 Ft. from E. Line

_____ Ft. from W. Line

		6	

Kearny County

RECORD

Location _____

Cased _____ in., _____ ft.

Rig up _____

Sand _____

Drilling and Remarks:

Gas _____

Oil _____

Total Depth 2700

PRODUCTION

1st 24 hrs. Nat. _____

1st 24 hrs. after shot _____

Gas _____ Cu. Ft.

Dry Hole _____

Abandoned _____

Date

FEB 26 1947 19S. J. LEWIS Scout

ND 2700
5" 02692
Prof.
65,000 cu. ft.
3,073,000 gal
897 4 R 1/2