

Stafford


KANSAS

SECTION 21 TOWNSHIP 24 RANGE 12 W

WELL NO. #1 Byer

COMPANY Stearns Pet.

NORTH

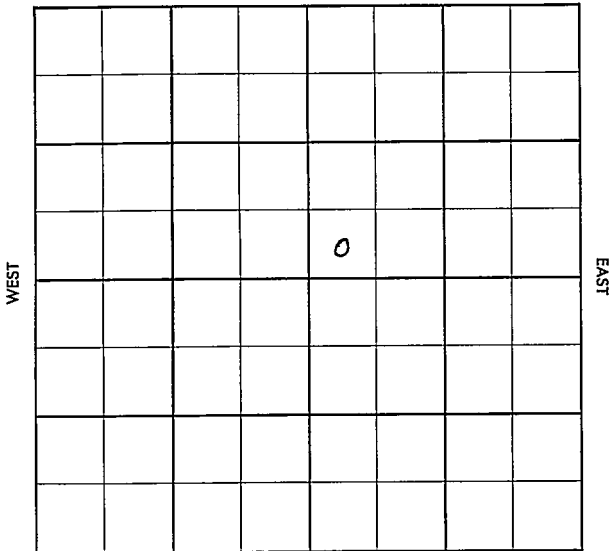

SOUTH

Stafford

KANSAS

SEC.	TWP.	R.
21	24	12W

WELL NO.

#1 Byer

FARM

COMPANY

Stearns Pet.

CONTRACTOR

Stearns

WILDCAT


_____ Ft. from N. Line

_____ Ft. from S. Line

_____ Ft. from E. Line

_____ Ft. from W. Line

SW SW NE

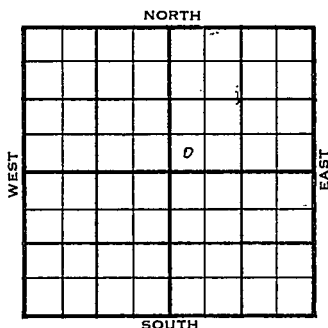

1956

ELEVATION
1885 DF

REPORT

1-25

Comm. 1-21-56
8" @ 252/180
Drlg. 1840

2-8

DST 3698-3705, op 1 hr. rec 15' mud,
BHP 220/30"
DST 3924-33 op 1 hr. rec. 20'drlg.mud
No press recorded
RTD 4135
No log.
D & A
H. 3336
Tr. 3358
BL 3491
L. 3520
V. 3923
A. 4116
TD 4135'

ABANDONED

County Stafford Elev. _____
 Sec. 21 Twp. 24 Rge. 12W
 Company Stearns Pet.
 Farm Name Byer No. 1

TOPS	DEPTH	LOG	DATUM	Loc. in Sec. _____
Anh.				SW SW NE
Tr.				
H.				
Dg.				
BL.				
L.				
K.C.				Geol. _____
B.K.C.				Contr. _____
Ce.				Stearns
C.				
M.				Pool _____
M.				Wildcat
K.				
Mz.				
Mo.				
V.				
S.				
S.				
A.				
R.				
Pe.				
G.				
T.D.				

FIRST REPORT	
JAN 25 '56	

Date Comm. 1-21-56

8" @ 252/180 drlg. 1840

13

FORM B13 REV. SUNRAY

County **Stafford** Elev. **X 1885 DE** Co.
 Sec. **21** Twp. **24** Rge. **12W**
 Company **Stearns Pet.**
 Farm Name **Byer** No. **1**

TOPS	DEPTH	LOG	DATUM	Loc. in Sec.
				SW SW NE
	3336			
	3358			
	3491			
	3520		1635	Pat CLOWERS Geol BILL RICHARDS
				Contr.
				Stearns
				Pool
				Wildcat
	3923		2038	
	4116		2231	
	4135			ABANDONED

Date Comm. **1-21-56**

FEB 8 1956

8" @ 252/180 drlg. 1840 FEB 1 '56 DST

3698-3705 FEB 8 '56 X O.A. 1 hr. rec.

15' Md BHP 220/30" Viol 3923

DST 3824-33 op 1 hr. rec. 20' p

Md no press Recorded. Feb 4 11/6

ATO 4135 No Log

W & R