

21

24

12 W

Section \_\_\_\_\_ Township \_\_\_\_\_ Range \_\_\_\_\_

# 1 Grieve

Well No. \_\_\_\_\_

Company Walters Drlg. \_\_\_\_\_

NORTH

							0

WEST

EAST

SOUTH



Sec. 21 Twp. 24 R. 12W

Well No. #1 Grieve Farm

Walters Drlg. Company

Walters Drlg. Contractor

Wildcat


990 Ft. from N. Line

\_\_\_\_\_ Ft. from S. Line

330 Ft. from E. Line

\_\_\_\_\_ Ft. from W. Line

SE NE SE

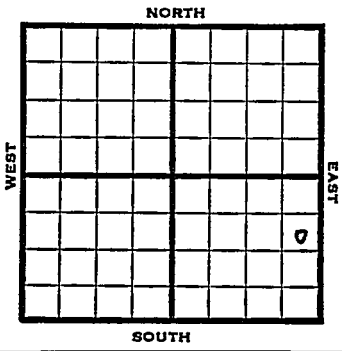

1953 Elev. 1879' REPORT

6/10 Spud 6-3-53  
8" @ 289  
Drlg. 2939'

6/24 NR

7/1 NR

7/15 Spud 6-3-53  
D&A  
TD 4127  
8" @ 289  
Anhy 687, Heeb 3322, Br lime 3480, Lans 3506  
DST 3660-95, opn 1 hr., rec. 390' gas, 150' gcm, 900#  
Viola 3910  
DST 3908-18, opn 1 hr., gas in 35 mins. rec. 75' ho & gcm, 210' mco, 78' oil, 150' sw, 1095#  
Simp 4040, Arb 4102  
TD 4127  
5" @ 4117  
DST 3918-28, opn 1 hr., rec. 150' gas, 2620' wtr, 1095#  
CO to 4100  
18/3959-65, 500A, 1000' wtr  
PB 3950, 42/3919-26 wtr, 36/3906-13, S/4 boph 12 hrs., 250A

OVER

(Information Brought Forward)

I953  
7/15

FU 2000' wtr.,  
28/3908-14,  $\frac{1}{2}$  bf 3 hrs., 75% wtr.  
200A, S/8 bw 5 bo  $3\frac{1}{2}$  hrs.  
D&A

**ABANDONED**



