
KANSAS
FORM 51 5M 1-42 PETROL

Stafford

Section 21 Township 24 Range 13 W

Well No. #2 Beckridt

Company Stanolind & Derby

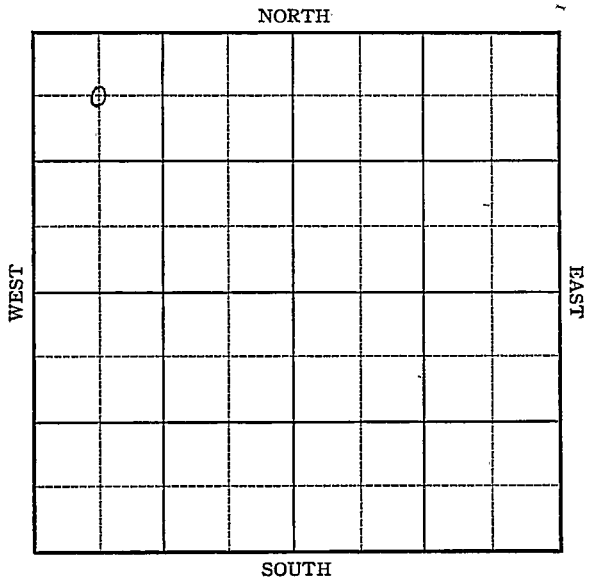

FORM 252-A
5M 9-42 GASS

KANSAS Stafford

Sec. 21 Twp. 24 R. 13-W

Well No #2 Beckridt Farm

Stanolind & Derby Company


Van Lieu

660 Ft. from N. Line

_____ Ft. from S. Line

_____ Ft. from E. Line

660 Ft. from W. Line

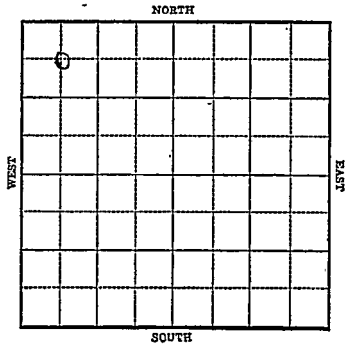

Elev. 1926

1943	REPORT
7/7	Derrick
7/15	Drlg. 775'
7/21	8" @ 1297' Drlg. 2330'
7/28	Lans 3550 Drlg. 3674'
8/4	Drlg. 3751'
8/11	Viola 3940 Arb 4062 T.D. 4069 Run Csg.
8/18	Arb 4256-76 T.D. 5" @ 4070 1000 acid
8/25	Arb 4062 5" @ 4070 1000 acid Dept Pot. 2580 oil & 4% water T.D. 4076' Gravity 39.7

COMPLETED

Form 26 200 Bks 5-42 Pet. Stafford

KANSAS

Map No. 2 Sec. 21 Twp. 24 R. 13W


Well No. 2 Beckridt

Stanolind & Derby Company

FIRST REPORT Contractor

C NW NW

SECTION PLAT

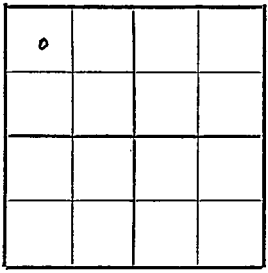

660 Ft. from N. Line

____ Ft. from S. Line

____ Ft. from E. Line

660 Ft. from W. Line

VAN LIEU POOL

Location

Rig up

Drilling and Remarks:

Derrick

RECORD

Cased ____ in., ____ ft.

Sand

Gas

Oil

Total Depth

PRODUCTION

1st 24 hrs. Nat.

1st 24 hrs. after shot

Gas ____ Cu. Ft.

Dry Hole

Abandoned

Date

JUL 7 1943 19

S. J. LEWIS Scout

Form 26 200 Bks 5-42 Petrol

Stafford

KANSAS

Map No. 23 Sec. 21 Twp. 24 R. 13W

Well No. 2 Beckridt

Stanolind & Derby Company

COMPLETED Contractor

C NW NW

660 Ft. from N. Line


Ft. from S. Line

Ft. from E. Line

660 Ft. from W. Line

Van Lieu Pool

SECTION PLAT

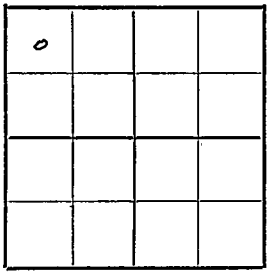

Location

Rig up

Drilling and Remarks:

Cr + 4062

5" @ 4070

1000 acid

Dep to Pa T.

2580 oil + 4% Water

39.7 Gr

RECORD

Cased in., ft.

Sand

Gas

Oil

Total Depth 4076

PRODUCTION

1st 24 hrs. Nat.

1st 24 hrs. after shot

~~Gas~~ Cu. Ft.

Dry Hole

Abandoned

Date

AUG 25 1943 19

S. J. LEWIS Scout