


Section 21 Township 24 Range 13W

Well No. 1 Pound Est

Company Federal Oil

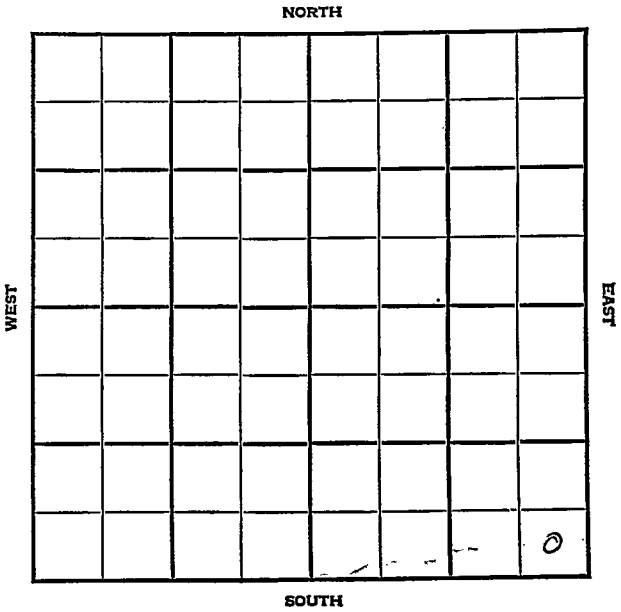

Stafford **KANSAS**

Sec. 21 Twp. 24 R. 13W

Well No. #1 Pound Est. Farm

Federal Oil Company
Van Lien


 Ft. from N. Line

330 Ft. from S. Line

330 Ft. from E. Line

 Ft. from W. Line

SE/C

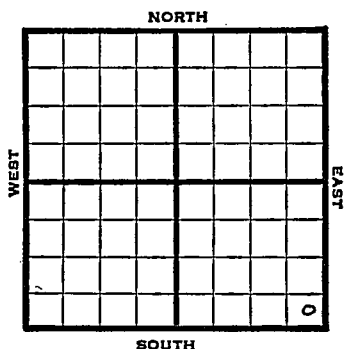

1947 Elev. 1929' REPORT

12/23 Location

1948
1/7 8" @ 450'
WOO-- -- --

1/14 Heebner 3418'
Drlg 3530'

1/21 Lans. 3580'
Viola 13994'
Simp. 4100'
Arb. 4147'
TD 4163'
Abd.

ABANDONED

Map No. _____ Sec. 21 Twp. 24 R. 13W

Well No. 1 Pound Est.

Federal Oil Company

FIRST REPORT Contractor

SE/C


SECTION PLAT

_____ Ft. from N. Line

330 Ft. from S. Line

330 Ft. from E. Line

_____ Ft. from W. Line

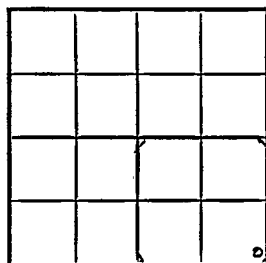

Stafford County

Location X

Rig up _____

Drilling and Remarks: _____

RECORD

Cased _____ in. _____ ft.

Sand _____

Gas _____

Oil _____

Total Depth _____

PRODUCTION

1st 24 hrs. Nat. _____

1st 24 hrs. after shot _____

Gas _____ Cu. Ft.

Dry Hole _____

Abandoned _____

Date

DEC 23 1947

19

S. J. LEWIS

Scout

Map No. 83 Sec. 21 Twp. 24 R. 13W


Well No. 1 Pound Est.

Federal Oil Company

ABANDONED Contractor

SE/C

E 11/1929
SECTION PLAT

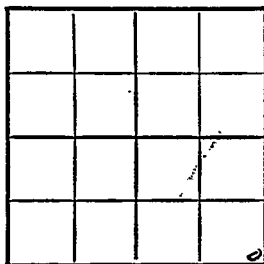

Ft. from N. Line

330 Ft. from S. Line

330 Ft. from E. Line

Ft. from W. Line

Stafford County

Location

Rig up

Drilling and Remarks:

Lane 3580
Wata 3994
Sim 4100
Cr 4147

RECORD

Cased in. ft.

Sand

Gas

Oil

Total Depth 4163

PRODUCTION

1st 24 hrs. Nat.

1st 24 hrs. after shot

Gas Cu. Ft.

Dry Hole

Abandoned

Date

JAN 21 1948

19

S. J. LEWIS

Scout