

Stafford

KANSAS

SECTION 21 TOWNSHIP 24S RANGE 14W

WELL NO. #1-Suiter

COMPANY H. G. Kaiser

NW NW NE

NORTH

WEST

EAST

				0			

SOUTH

Stafford

KANSAS

SEC.	21	TWP.	24 S	R.	14 W
------	----	------	------	----	------

WELL NO. # 1 Suiter FARM

COMPANY H. G. Kaiser

CONTRACTOR Armer


Dillwyn

\_\_\_\_\_ FT. FROM N. LINE

\_\_\_\_\_ FT. FROM S. LINE

\_\_\_\_\_ FT. FROM E. LINE

\_\_\_\_\_ FT. FROM W. LINE

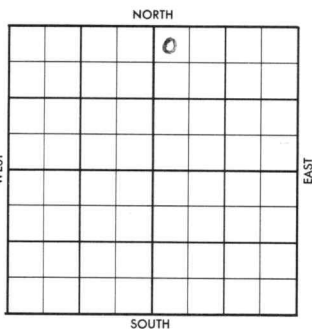

NW NW NE

SDX-Offset

1957	ELEVATION	REPORT
------	-----------	--------

7/10 Location (FR Tkt)

County Stafford Elev. \_\_\_\_\_  
 Sec. 21 Twp. 24 Rgs. 14W  
 Company H. G. Kaiser  
 Farm Name Suiter No. 1

TOPS	DEPTH	LOG	DATUM	Loc. in Sec.
Anh.				NW NW NE
Tp.				
H.				
Tr.				
Dg.				
Bl.				
L.				Geol. _____
K.C.				Contr. _____
B.K.C.				
Ce.				<u>Armer</u>
C.				Pool
M.				<u>Dillwyn</u>
M.				
K.				
Mz.				
Mq.				
V.				
S.				
S.				
A.				
R.				
Pf.				
G.				
T.D.				

JUL 10 '57  
 FIRST REPORT  
 SDX - OFFSET

Date Comm. \_\_\_\_\_  
 Location \_\_\_\_\_

\_\_\_\_\_

13

JUL 15 1957

M.M

Co.  
 Sec.  
 T.  
 R.

Co.

Lse.

No.

Sec.

T.

R.

County Stafford Elev. 1972  
 Sec. 21 Twp. 24 Rge. 14W  
 Company H. G. Kaiser  
 Farm Name Suiter No. 1

	TOPS	DEPTH	LOG	DATUM
		3529	3528	
		3550	3547	
Dp			3564	
BL		3669	3669	
L.		3691	3689	
K.C.				
B.K.C.			3957	
Ce.	<u>Max</u>	3976	3972	
C.	<u>91</u>	4058		
M.		4060		
M.				
K.	<u>sd</u>	4084		
Mz.				
Ma.				
V.		4157	4120	
S.	<u>sl</u>	4245	4292	
S.	<u>sd</u>	4260	4257	
A.		4299	4201	
R.				
PE.				
G.				
T.D.		4819		

Loc. in Sec. NW NW NE  
 Geol. \_\_\_\_\_  
 Contr. Armer  
 Pool Dillwyn  
 ABANDONED  
 0 Offset  
 AUG 21 '57

Date Comm. Phillips F.O.  
 Location AR 17 '57 JUL 24 '57 JUL 31 '57

7-26-57 85/8 243/175  $\emptyset$   
~~1923~~  $\emptyset$  2136 AUG 2 '57 Lost hole  
 @ 2256 Skid rig 20' 85/8  
 @ 230/185  $\emptyset$  1460 AUG 14 '57  
 $\emptyset$  3898 AUG 21 '57 DST 3847-3960 op 11r  
 75 W/M EP 105-105 BHP 1320/20 DST 4087-  
 4110 op 11r R. 15' M BHP 00 DST 4144-4206 op 11r  
 R. 65' MW BHP 235 EP 80-100  
 15'

DST 9302-06 14v R 98' SWFWtr.

EP 0" BHP 1410"

STP. DST 3798-384' op 14. Rec

30' WM BHP 0<sup>2</sup>/<sub>10</sub>

D: A