

# KANSAS

COMPANY D.R. Lauck

A 10x10 grid with directional labels: NORTH, SW, SE, EAST, SOUTH, WEST. The grid contains handwritten numbers: '0' in the 8th row, 5th column and '1' in the 8th row, 7th column.

SEC. 21 TWP. 24 S R. 17 W

WELL NO. # 1 Massey FARM

COMPANY D. R. Lauck (EXPLORATORY-OBOC)

CONTRACTOR Co. Tools


Wayne

\_\_\_\_\_ FT. FROM N. LINE

330 \_\_\_\_\_ FT. FROM S. LINE

\_\_\_\_\_ FT. FROM E. LINE

330 \_\_\_\_\_ FT. FROM W. LINE  
 of SE/4  
 SW SW SE

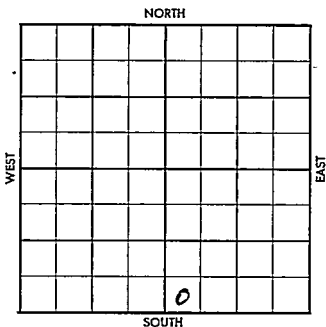

### ELEVATION

|       |                                                                                        |
|-------|----------------------------------------------------------------------------------------|
| 1957  | 2115' Gr. 2118' DREPORT                                                                |
| 9/25  | 4400' Miss. Test<br>Location (FR Tkt)                                                  |
| 10/23 | Spud 10-18-57<br>Set 8-5/8" @ 243 w/185 sks. (DR 208)<br>Drlg. 2700' (Card-D.R. Lauck) |
| 10/24 | Drlg. 3040' "                                                                          |
| 10/25 | Drlg. 3375' "                                                                          |
| 10/26 | Drlg. 3615' "                                                                          |
| 10/27 | Drlg. 3875' "                                                                          |
| 10/28 | Drlg. 4020'<br>Heeb 3765' Douglas 3800'<br>Brown lime 3888' "                          |
| 10/29 | Drlg. 4155' "                                                                          |
| 10/30 | Drlg. 4285' "                                                                          |
| 10/31 | Drlg. 4375' "                                                                          |
| 11/1  | Drlg. 4440' "                                                                          |
| 11/2  | Drlg. 4535' "                                                                          |
| 11/4  | NR                                                                                     |
| 11/5  | NR                                                                                     |
| 11/6  | NR                                                                                     |
| 11/7  | TD 4560' P & A (DR#218)                                                                |

4450  
 2118  
 2362

3898  
 2118  
 1780

Pique

X4

S-513-A

CO. Edwards ELEV. \_\_\_\_\_  
SEC. 21 TWP. 24 RGE. 17W  
COMPANY D. R. Lauck NO. 1

|              |    |
|--------------|----|
| FIRST REPORT |    |
| SEP 25       | 57 |
| 6            |    |

FARM Massey

LOC. SW SW SE

|  |  |
|--|--|
|  |  |
|  |  |
|  |  |
|  |  |
|  |  |
|  |  |
|  |  |
|  |  |
|  |  |
|  |  |

GEOL. \_\_\_\_\_  
CONTR. Co. Tools  
POOL Wayne  
SPUD \_\_\_\_\_  
Location

CO. \_\_\_\_\_  
LSE. \_\_\_\_\_  
NO. \_\_\_\_\_  
SEC. \_\_\_\_\_  
TWP. \_\_\_\_\_  
RGE. \_\_\_\_\_

~~Rique~~

~~CONNECTION~~

CO. Edwards <sup>Est.</sup> ELEV 21180F  
SEC. 21 TWR. 24 RGE. 17W  
COMPANY D. R. Lauck NO. 1

NOV 6 '57

ABANDONED

and 5DX

FARM Massey

LOC. SW SW SE

GEOL.

CONTR. Co. Tools

POOL Wayne

SPUD 10-18-57

Location

DIST 8

23 57

8" 243/

Ab 1135 D2078

Hb 3765 Dg 3796

BL 3888. Lsg 3897

4130 AGG 6" X u sd 4352 DST

4339-60 30" WB 4" no rec

M 4379 DST 4379-84 60" GB

rec 30' M BHP 480/30" FPO DST

4384-4416 60" GB fault-rec

2640' gas 90' oil to GCM 60'

G oil to wtr CM FPO BHP 792/20"

Ksh 4428 U 4482 ran log RTD

4560 Log tops Hb 3763

TR 3778 Dg 3795 BL 3888

Lsg 3898 Ce sd 4351

M 4379 Ksh 4424 Ksd 4428

Ksh 4454 MZ 4471 V 4480

LTD 4559

DLA