


Section 21 Township 24 Range 24WWell No. #1 D011Company B & R Drlg.

NORTH

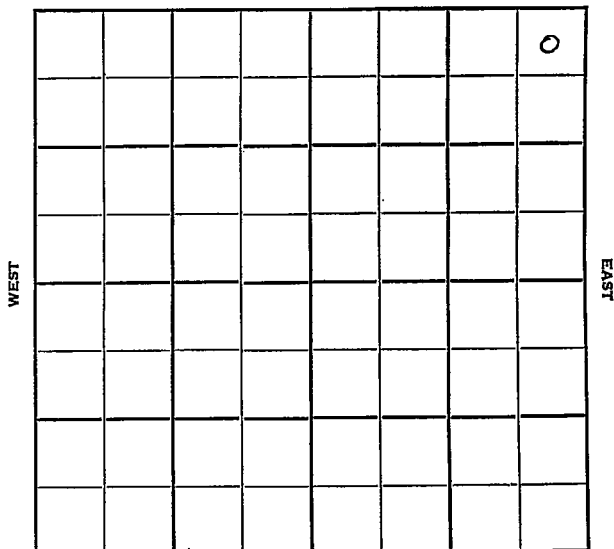

SOUTH

Hodgeman

KANSAS

Sec. 21 Twp. 24 R. 24 W

Well No. # 1 Doll Farm

B & R Drlg. Company

Contractor

**Wildcat**


330 Ft. from N. Line

       Ft. from S. Line

330 Ft. from E. Line

       Ft. from W. Line

NE NE NE

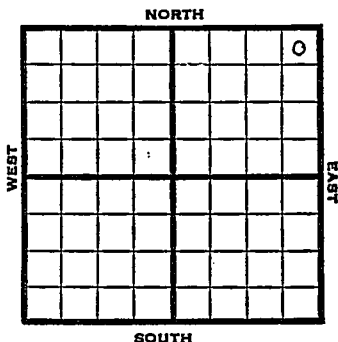

1951

Elev. 2199' REPORT

6/20

**Location**

8/8

Spud 7-8-51

D & A TD 4915' 8" @ 180'

KC 4123' Heeb 4052' B KC 4534'

Cong. 4773' Miss 4883'

TD 4915' D & A

**ABANDONED**

County Hodgeman State Kansas

Sec. 21 (Blk. Twp.) 24 (Sur. Rge.) 24W Map No.

Operator B & R D-13

Well No. 1 Farm D-33

| Elev. | Location | NE | NE | NE |
|-------|----------|----|----|----|
|-------|----------|----|----|----|

330 Ft. From NY Line RTD

330 Ft. From E Line Quarter

1st. Report JUN 20 1951

## Completion

Remarks

Spudding Date

Drig. Data W110000

Location

County Hodgeman State Kansas  
 Sec. 21 (Blk. 24) (Sur. 24W) Map No. 24W  
 Operator B & R Drlg.  
 Well No. 1 Farm Doll  
 Elev. 2499 Location NE NE NE

|  |  |  |  |  |  |   |
|--|--|--|--|--|--|---|
|  |  |  |  |  |  | 0 |
|  |  |  |  |  |  |   |
|  |  |  |  |  |  |   |
330 Ft. From N Line NE  
330 Ft. From E Line Quarter

1st. Report

Completion AUG 8 195

Remarks Wildcat

Spudding Date 7-8-51

Drlg. Data D & A TD 4915

8" @ 180 KC 4123 Heeb. 4052 B KC 4534

Cong. 4773 Miss. 4883 TD 4915

D & A

J. E. TYRA