


Section 21 Township 24 Range 33W

Well No. #1 McWilliams "E"

Company Cities Service Oil

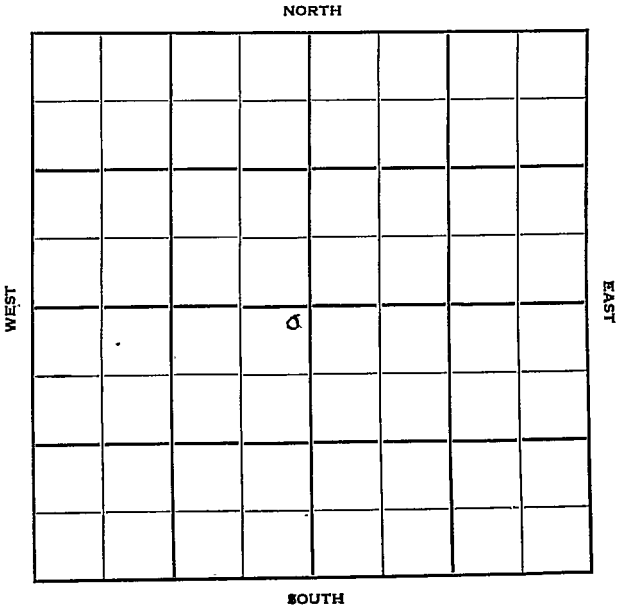

Finney

Sec. 21 Twp. 24 R. 33W ✓

Well No. #1 McWilliams "E" Farm

Cities Service Oil Company


Hugoton Pool

100' Ft. from N. Line

 Ft. from S. Line

100' Ft. from E. Line

 Ft. from W. Line

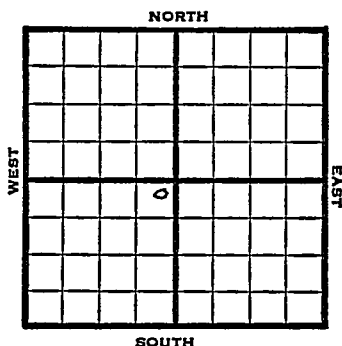

NE SW

1950 Elev. 2920' REPORT

3/29 Location
5/10 TD 2740'
8" @ 800'
5" @ 2739'
Herrington 2538'
Krider 2564'
Winn 2620'
Ft Riley 2682'
15,900,000 GFGPD
Comp

COMPLETED

Kansas

Hugoton Pool

Map No. _____ Sec. 21 Twp. 24 R. 33W

Well No. 1 McWilliams "E"

Cities Service Oil Company

Contractor

NE SW


E1. 2920
SECTION PLAT

100 Ft. from N. Line

_____ Ft. from S. Line

100 Ft. from E. Line

_____ Ft. from W. Line

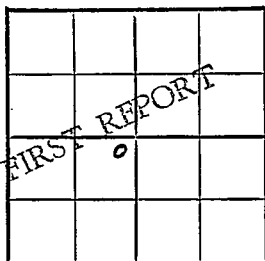

Finney County

Location X

Rig up _____

Drilling and Remarks:

RECORD

Cased _____ in., _____ ft.

Sand _____

Gas _____

Oil _____

Total Depth _____

PRODUCTION

1st 24 hrs. Nat. _____

1st 24 hrs. after shot _____

Gas _____ Cu. Ft.

Dry Hole _____

Abandoned _____

Date

MAR 29 1935

19

J. E. TYRA

Scout

Kansas

Map No. _____ Sec. 21 Twp. 24 R. 33WWell No. 1 McWilliams "E"

_____ Cities Service Oil _____ Company

Contractor


NE SW

E. 2920
SECTION PLAT100 Ft. from N. Line

_____ Ft. from S. Line

100 Ft. from E. Line

_____ Ft. from W. Line

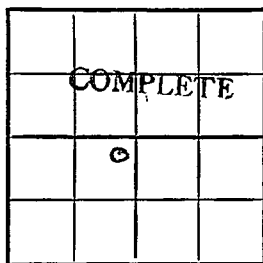

Finney

Location _____

Rig up _____

Drilling and Remarks:

*8" @ 800**5" @ 2739**Herrington 2538**Ryder 2564**Winn 2620**FT Riley 2682**15,900 000**CFC PD*

Date

MAY 10 1950

RECORD

Cased _____ in., _____ ft.

Sand _____

Gas _____

Oil _____

Total Depth *2740*

PRODUCTION

1st 24 hrs. Nat. _____

1st 24 hrs. after shot _____

Gas *✓* _____ Cu. Ft.

Dry Hole _____

Abandoned _____

J. E. TYRA

Scout

19