

KANSAS


FORM 51 5M 1-42 PETROL


Stafford

Section 22 Township 24 Range 11-W

Well No. #1 Paulsen

Company D.R.M.

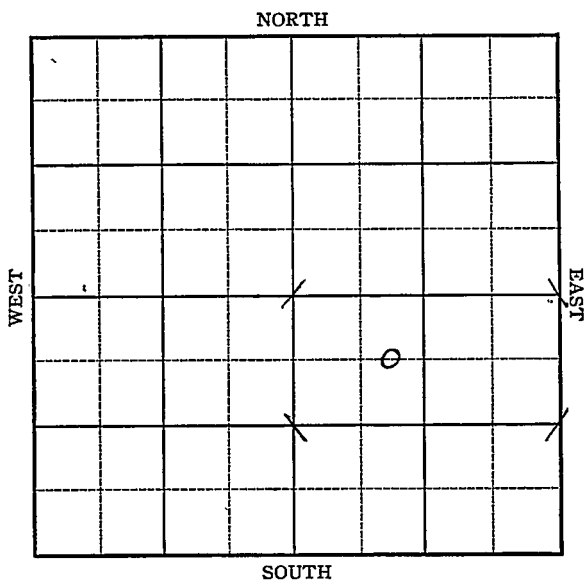

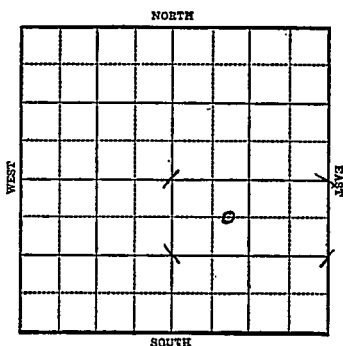Sec. 22 Twp. 24 R. 11-WWell No. #1 Paulsen FarmD.R.M. Company660 Ft. from N. Line Ft. from S. Line Ft. from E. Line990 Ft. from W. Line*Flow. 1814*

1943

R E P O R T

5/5 Surface hole.

5/12 10" @ 265'
Drlg. 3478'5/19 Lans 3416
Misiner 3828
Viola 3851
T.D. 3906
5" @ 3906 Rust5/26 24 shots 3864-71
No show 500 acid

6/2 36 shots 3842-50 water P.B.

6/9 12 snots 3826-31-1000 acid
1800' water

6/16 " "

6/23 " "

6/30 " "

7/7 " "

7/15 " "

7/21 " "

7/28 " "

8/4 " "

8/11 " "

8/18 " "

OVER

1943

8/25 12 shot 3826-31 1000 acid 1800'
Wtr.

9/1 "

9/8 Viola 3851
5" @ 3906
Perf. Viola
2500 acid
Water
T.D. 3906'

ABANDONED

Stafford

~~KANSAS~~Map No. Sec. 22 Twp. 24 R. 11 WWell No. 1 Paulsen

D. R. M.

Company

FIRST REPORT

Contractor

C EL NW SE

SECTION PLAT

660


Ft. from N. Line

Ft. from S. Line

Ft. from E. Line

990

Ft. from W. Line

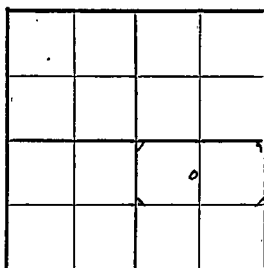

ZENITH POOL

Location

Rig up

Drilling and Remarks:

Surface Hole

RECORD

Cased in., ft.

Sand

Gas

Oil

Total Depth

PRODUCTION

1st 24 hrs. Nat. 1st 24 hrs. after shot Gas Cu. Ft.Dry Hole Abandoned

Date

MAY 5 1943

19

S. J. LEWIS

Scout

KANSAS

Map No. 47 Sec. 22 Twp. 24 R. 11WWell No. 1 Paulsen

D R M

Company

ABANDONED

Contractor

C E L NW SE

660

Ft. from N. Line

Ft. from S. Line

Ft. from E. Line

990

Ft. from W. Line

Zenith Pool

SECTION FLAT

Location

Rig up

Drilling and Remarks:

Viola 3801
4" @ 3906
Perf Viola
2500 @ 4100
Water.

RECORD

Cased _____ in., _____ ft.

Sand _____

Gas _____

Oil _____

Total Depth 3906

PRODUCTION

1st 24 hrs. Nat. _____

1st 24 hrs. after shot _____

Gas _____ Cu. Ft.

Dry Hole _____

Abandoned _____

Date

SEP 8 1943 19

S. J. LEWIS Scout