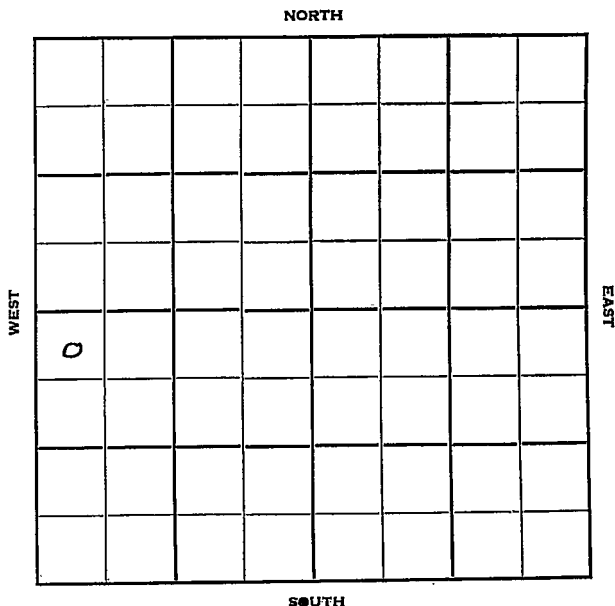


Section 22 Township 24 Range 11WWell No. #3 RichardsonCompany Sohio

Stafford KANSAS

Sec. 22 Twp. 24 R. 11 W

Well No. # 3 Richardson Farm

Sohio Company

Stearns Contractor

Richardson


330 Ft. from N. Line

Ft. from S. Line

Ft. from E. Line

330 Ft. from W. Line

NW NW SW

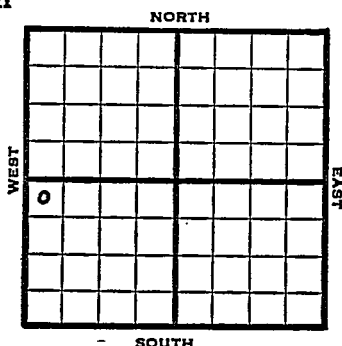

1952 Elev. 1823' REPORT

1/9 Spud 1-8-52
Drilling
1/23 Spud 1-8-52
D&A TD 3884
8" @ 309 Heeb. 3243 Tor. 3261
Br Li 3397 Lans. 3428
DST 3446-68 open 1 hr. rec. 25'
mud & SW Cong. 3720
DST 3718-44 open 1 hr. rec. 10' mud
Kh. 3734 Viola 3822
DST 3824-36 open 1 hr. rec. 90' SO&GCM
TD 3884
D&A

3822
1823
1999

ABANDONED



Drig.

"J. E. TYRA

J. G. McGEHEE