

KANSAS

Stafford

Sec. 22 Twp. 24 R. 12-W

Well No. #1 Cooper Farm

Continental Company

(Stafford)


330 Ft. from N. Line

_____ Ft. from S. Line

660 Ft. from E. Line

_____ Ft. from W. Line


Elv. 1864

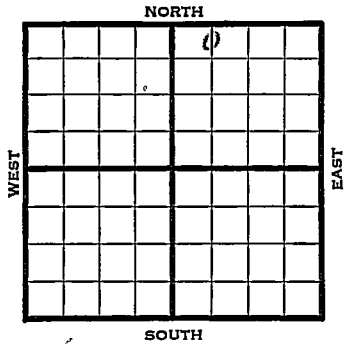

1941	REPORT
12/3	Derrick.
12/18	Rotary
12/24	10" - 438' WOC.
12/31	Drlg. 3620'
1942	
1/8	Lans. 3482' Marmation 3800'
	Viola 3869' S.O. T.D. 3890'
1/15	Arb. 4067' T.D. 4084' S.W.
1/22	6" - 3940' P.B. to 3916'
	24 shots 3892-3900'
1/29	P.B. to 3890'
2/4	Arb. 4067'
	6" - 3940'
	T.D. 4084'
	Water.
	ABANDONED

Map No. 47 Sec. 22 Twp. 24 R. 12WWell No. 1 CooperContinental CompanyFIRST REPORT Contractor

SECTION PLAT

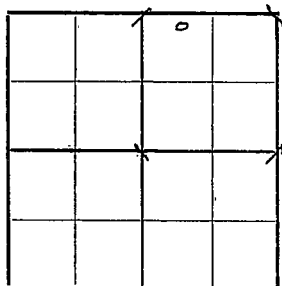C $N\frac{1}{2}$ NW NE330 Ft. from N. Line

_____ Ft. from S. Line

660 Ft. from E. Line

_____ Ft. from W. Line

STAFFORD POOL

Location _____

Rig up _____

Drilling and Remarks:

Derrick

RECORD

Cased _____ in., _____ ft.

Sand _____

Gas _____

Oil _____

Total Depth _____

PRODUCTION

1st 24 hrs. Nat. _____

1st 24 hrs. after shot _____

Gas _____ Cu. Ft.

Dry Hole _____

Abandoned _____

Date

DEC 3 1941 19S. J. LEWIS Scout

Map No. 47 Sec. 22 Twp. 24 R. 12W

Well No. 1 Cooper

Continental Company

ABANDONED Contractor

SECTION PLAT

C $N\frac{1}{2}$ NW NE
330 Ft. from N. Line
 _____ Ft. from S. Line
 _____ Ft. from E. Line
660 Ft. from W. Line

		o	

STAFFORD POOL

Location _____

Rig up _____

Drilling and Remarks:

*Cor 4067
 6" @ 3940
 Water.*

RECORD

Cased _____ in., _____ ft.
 Sand _____
 Gas _____
 Oil _____
 Total Depth 4084

PRODUCTION

1st 24 hrs. Nat. _____
 1st 24 hrs. after shot _____
 Gas _____ Cu. Ft.
 Dry Hole _____
 Abandoned _____

Date

FEB 4 1942 19

S. J. LEWIS Scout