


Section 22 Township 24 Range 12W

Well No. #2 Erhart

Company Deep Rock

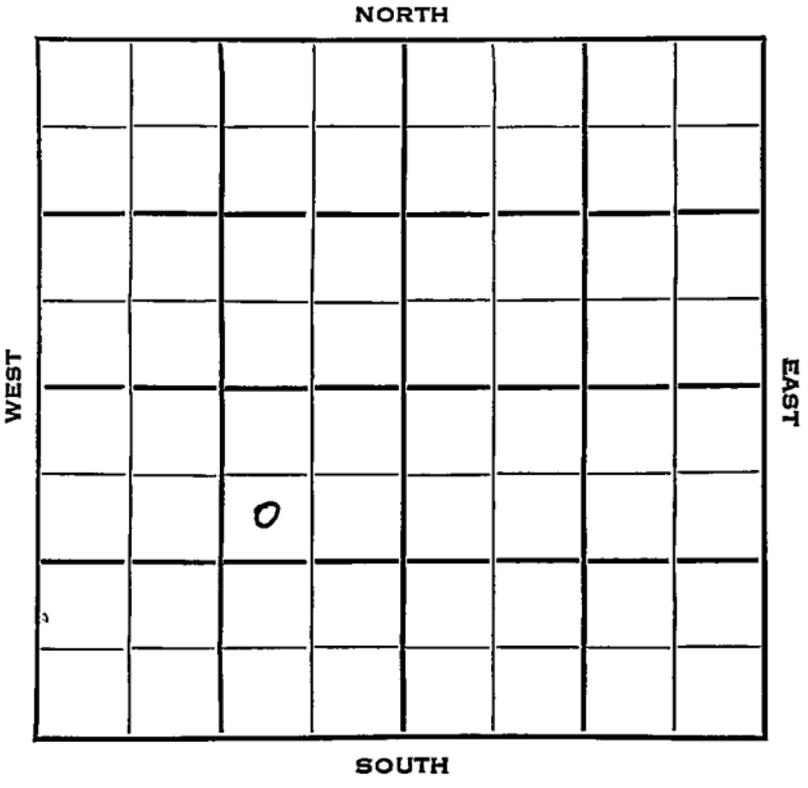

Stafford

KANSAS ✓

Sec. 22 Twp. 24 R. 12 W

Well No. #2 Erhart Farm _____

Deep Rock Company _____

Gabbert & Jones Contractor _____

North Star Pool


990 Ft. from N. Line

_____ Ft. from S. Line

990 Ft. from E. Line

_____ Ft. from W. Line

SW NE SW

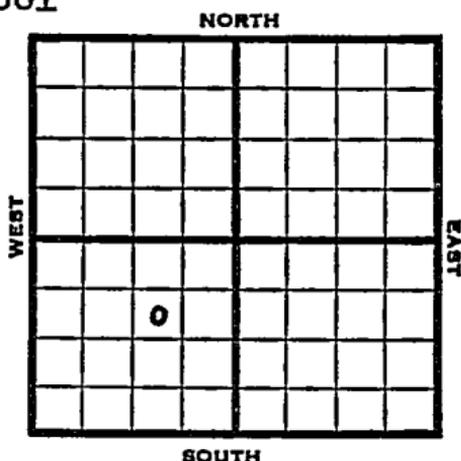

1953 Elev. 1881' REPORT

8/19 Spud 8-14-53
8" @ 321
Drlg. 2265'

8/26 Drlg. 3860'

9/2 Heeb 3329, Br. L. 3484, Lans 3510,
V. 3935,
DST 3939-53 1/2 hr, 12' M, Simp 4042,
Arb 4084
DST 4084'-88 1/2 hr, 6' OCM, 1250#
DST 4088'-91' 1 1/2 hr, 60' Hly OCM, 60'
mco 1150# RTD 4091'
Schl.

9/9 5" @ 4087'
CO 4091 12 GOPH 500 A S/1/2 BFPH
70% water.
Drlg. 4135'

9/16 S/ 2 1/2 bfph

9/23 Spud 8-14-53 D & A TD 4091
8" @ 321 Heeb 3329 Br lime 3484
Lans 3510 Viola 3935
DST 3939-53 open 1/2 hr rec 12' mud
Simp. 4042' Arb. 4084
DST 4084-88 open 1/2 hr rec 6' OCM
1250#
DST 4088-91 open 1 1/2 hr rec 60' HOCM
60' MCO 1150# TD 4091

OVER

1953
9/23

(Information continued)

5" @ 4087 CO to 4091 12 GOPH

500 A S/1/2 BFPH 70% wtr.

S/2 1/2 BFPH

D & A

ABANDONED

11

