


Section 22 Township 24 Range 12W

Well No. 1 Harvey S. Crawford

Company Sinclair

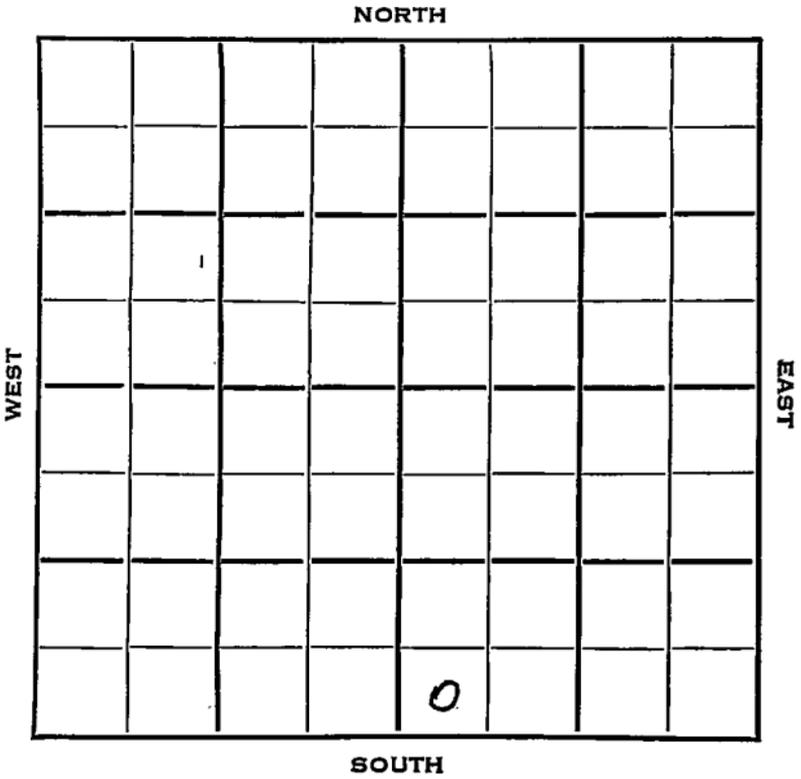

1953

Information brought forward.

10/14 Kh 3824, Viola 3906,
DST 3906'-51' opn 1 hr, rec 1400' gas,
90' ho & gcm 860# Simp 4033,
Arb 4090,
DST 4091'-95' opn 1 hr, rec 50' sw,
1375#
TD 4097'
D & A

ABANDONED


County Stafford State Kansas

Sec. 22 (Blk. Twp.) 24 (Sur. Rge.) 12W Map No.

Operator Sinclair

Well No. 7 Farm Harvey S. Crawford

Elev. _____ Location SW SW SE

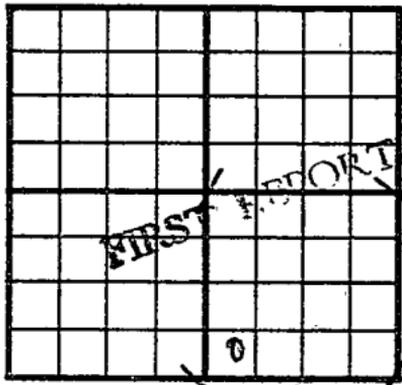

330Ft. From S Line SE

330Ft. From W Line Quarter

1st. Report SEP 16 1952

Completion _____

Remarks _____

Spudding Date _____

Drlg. Data North Star Pool

Location

County Stafford State Kansas

Sec. 22 (Blk. 24) (Sur. 12W) (Twp.) (Rge.) Map No.

Operator Sinclair

Well No. 1 Farm Harvey S. Crawford

Elev. 1878 Location SW SW SE

330 Ft. From S Line SE

330 Ft. From W Line Quarter

Ist. Report

Completion **OCT 14 1953**

Remarks North Star Pool

Spudding Date 9-16-53

Drig. Data D & A TD 4097

9" @ 323 Heeb. 3335 Lans. 3507

DST 3516-34 open 1 hr. Rec. 30' mud

0# DST 3574-97 open 1 hr. Rec.

195' sw 1260# DST 3640-55 open 1 hr.

Rec. 30' mud 30# Kh. 3824 Viola 3906

DST 3906-51 open 1 hr. Rec. 1400' gas

90' ho & gcm 860# Simp. 4033

Arb. 4090 DST 4091-95. open 1 hr.

Rec. 50' sw 1375# TD 4097

D & A