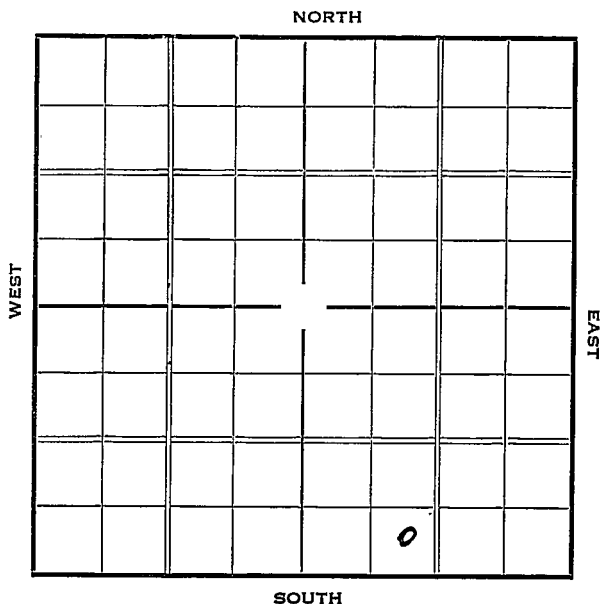


Section 22 Township 24 Range 13-WWell Number 2- FitzgeraldCompany Stanolind & Amerada

1937

9/29 6" @ 4128'.

Sil. 4130'.

T.D. 4133'.

1700' fluid, 50% water.

P.B. 4132'.

ABANDONED

Map No. _____ Sec. 22 Twp. 24 R. 13WWell No. 2 - FitzgeraldStanford & Amersale Company

Contractor

FIRST REPORT

SECTION PLAT

 Ft. from N. Line330 Ft. from S. Line Ft. from E. Line990 Ft. from W. Line

			0

Location _____

Rig up _____

Drilling and Remarks:

Moving in
Rat

RECORD

Cased _____ in., _____ ft.

Sand _____

Gas _____

Oil _____

Total Depth _____

PRODUCTION

1st 24 hrs. Nat. _____

1st 24 hrs. after shot _____

Gas _____ Cu. Ft.

Dry Hole _____

Abandoned _____

Date

JUL 14 1937 19H. D. Hatfield

Scout

Stafford **KANSAS**Map No. 83 Sec. 22 Twp. 24 R. 13WWell No. 2-FitzgeraldStanolind-Amerada Company

Contractor

ABANDONED

SE SW SE

330 Ft. from N. Line330 Ft. from S. Line Ft. from E. Line990 Ft. from W. Line

SECTION PLAT

			0

Location Rig up

Drilling and Remarks:

1700' fluid
50 gals waterP.B. 4132D & A

RECORD.

Cased 6 in., 4128 ft.~~Sand~~ 511 4130Gas Oil Total Depth 4133

PRODUCTION

1st 24 hrs. Nat. 1st 24 hrs. after shot Gas Cu. Ft.Dry Hole Abandoned

Date

SEP 29 1937

19

H. D. Hatfield

Scout