

KANSAS


Stafford


Form 51—5M—7-40—Palace

Section 22 Township 24 Range 13-W

Well No. #3 Fitzgerald

Company Stanolind

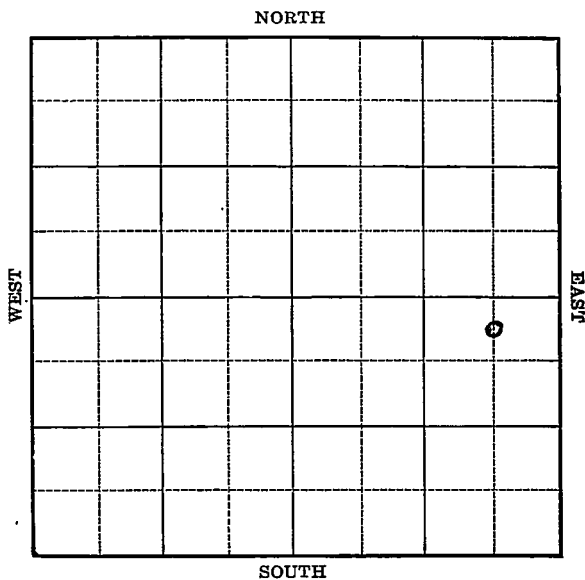

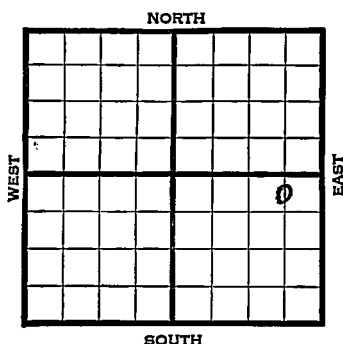[illegible]

Map No. 83 Sec. 22 Twp. 24 R. 13WWell No. 3 FitzgeraldStanolind Company~~FIRST REPORT~~ Contractor**SECTION PLAT**

C N L N E S E

330 Ft. from N. Line Ft. from S. Line660 Ft. from E. Line Ft. from W. LineMCNAGHTEN POOL

			o

Location Rig up

Drilling and Remarks:

Derrick**RECORD**Cased in., ft.Sand Gas Oil Total Depth **PRODUCTION**1st 24 hrs. Nat. 1st 24 hrs. after shot Gas Cu. Ft.Dry Hole Abandoned

Date

FEB 5 1941 19S. J. LEWIS Scout

Map No. 83 Sec. 22 Twp. 24 R. 13WWell No. 3 Fitzgerald

Stanolind _____ Company

_____/_____
Contractor**COMPLETED**

C N L NE SE

330 Ft. from N. Line

_____ Ft. from S. Line

660 Ft. from E. Line

_____ Ft. from W. Line

McNaghten Pool

SECTION PLAT

	.		o

Location _____

Rig up _____

Drilling and Remarks:

*Cor 84108**5" @ 4109**Depth 82200**37 5/8 in.***RECORD**

Cased _____ in., _____ ft.

Sand _____

Gas _____

Oil _____

Total Depth 4113**PRODUCTION**

1st 24 hrs. Nat. _____

1st 24 hrs. after shot _____

Gas _____ Cu. Ft.

Dry Hole _____

Abandoned _____

Date

MAR 26 1941 19 S. J. LEWIS Scout