

KANSAS

FORM 51 5M 4-41 PETROL

Stafford

Section 22 Township 24- Range 13-W

Well No. #2 Keller

Company Continental

NORTH McNaghten Pool

							0

WEST

EAST

SOUTH

KANSAS

Stafford

Sec. 22 Twp. 24 R. 13 -W

Well No. #2 Keller Farm
Continental Company

(McNaghten)

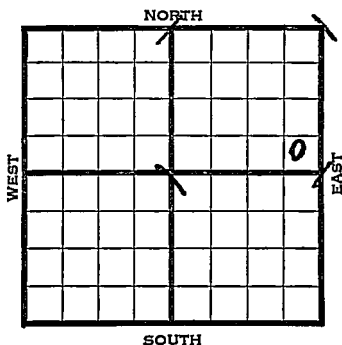
Ft. from N. Line

440 Ft. from S. Line

440 Ft. from E. Line

Ft. from W. Line

Elev. 1927

[illegible]

Map No. 83 Sec. 22 Twp. 24 R. 13WWell No. 2 KellerContinental

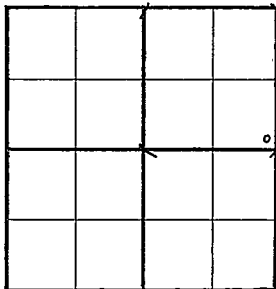
Company

FIRST REPORT

Contractor

SECTION PLAT

SE NE

 Ft. from N. Line440 Ft. from S. Line440 Ft. from E. Line Ft. from W. Line**McNAGHTEN POOL**Location Rig up

Drilling and Remarks:

Rotary

RECORDCased in., ft.Sand Gas Oil Total Depth **PRODUCTION**1st 24 hrs. Nat. 1st 24 hrs. after shot Gas Cu. Ft.Dry Hole Abandoned

Date

APR 9 1941 19S. J. LEWIS Scout

Map No. 83 Sec. 22 Twp. 24 R. 13WWell No. 2 KellerContinental Oil CompanyABANDONED Contractor

SE NE

 Ft. from N. Line440 Ft. from S. Line440 Ft. from E. Line Ft. from W. Line

McNaghten Pool

SECTION PLAT

Location Rig up

Drilling and Remarks:

*Ar 84127**Water*

RECORD

Cased in., ft.Sand Gas Oil Total Depth 4136

PRODUCTION

1st 24 hrs. Nat. 1st 24 hrs. after shot Gas Cu. Ft.Dry Hole Abandoned

Date

APR 30 1941 19

S. J. LEWIS Scout