


Section 22 Township 24 Range 13W

Well No. #1 McNaughton

Company Peel & Hardman

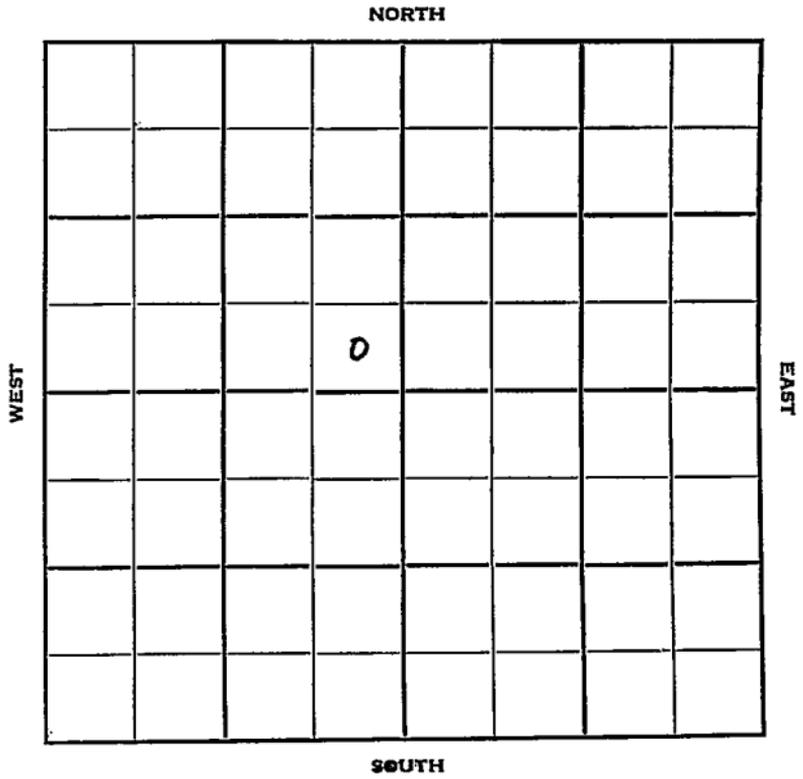


Sec. 22 Twp. 24 R. 13W ✓

Well No. #1 McNaughton Farm

Peel & Hardman Company

McNaughton Pool Contractor

_____ Ft. from N. Line
330' Ft. from S. Line
330' Ft. from E. Line
 _____ Ft. from W. Line
 SE SE NW

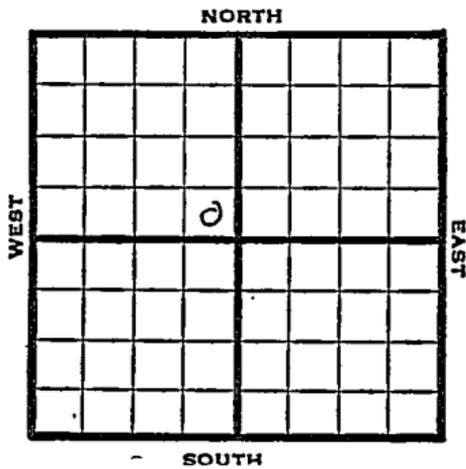

1950 Elev. 1922' REPORT

12/6 Spud 11-30-50
 8-5/8" @ 305
 Drlg. 2180'

12/27 Spud 11-30-50
 D&A TD 4193
 8-5/8" @ 305'
 Lans. 3380
 DST 3675-81 opn 1/2 hr.
 Rec. 150' wtr
 Viola 3958
 Simp. 4094
 Arb. 4152-93 TD

3958
 1922

 2036

ABANDONED

County Stafford State Kansas

Sec. 22 (Blk. Twp.) 24 (Sur. Rge.) 13W Map No.

Operator Peel & Hardman

Well No. 1 Farm McNaughton

Elev. _____ Location SE SE NW

		0			

330 Ft. From S Line NW

330 Ft. From T Line Quarter

Ist. Report DEC 6 1950

Completion _____

Remarks _____

Spudding Date 11-30-50

Drlg. Data McNaughton Pool

8 5/8" @ 305 drlg. 2180

