


KANSAS

Stafford

Section 22 Township 24 Range 14-W

Well No. #1 Stropher

Company M. B. Armen

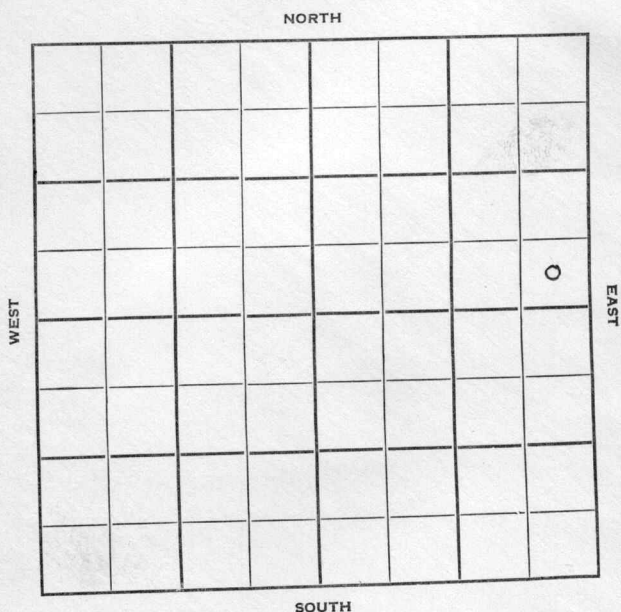

KANSAS

Stafford ✓

Sec. 22 Twp. 24 R. 14-W

Well No. #1 Stropher Farm

M. B. Armen Company

Contractor


Ft. from N. Line

330 Ft. from S. Line

330 Ft. from E. Line

Ft. from W. Line

SE SE NE

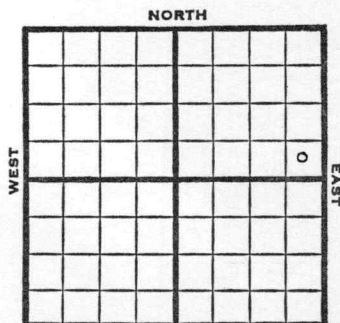

Phillips Farmout Shell DHM SOUTH

1950 Elev 1940 REPORT

6/7 Location

7/12 8" @ 356  
Anhy 858  
Skid rig 40' west  
8" @ 220  
Anhy 835  
Lans 3644  
Kinderhook 4052  
Simp 4178  
TD 4275  
D&A

Br lime 3616  
Miss 4005  
Viola 4107  
Arb 4221-75 TD

**ABANDONED**

Kansas

Map No. \_\_\_\_\_ Sec. 22 Twp. 24 R. 14WWell No. 1 StropherM. B. Armer Company

Contractor


SE SE NE

\_\_\_\_\_ Ft. from N. Line

330 Ft. from S. Line330 Ft. from E. Line

\_\_\_\_\_ Ft. from W. Line

## SECTION PLAT

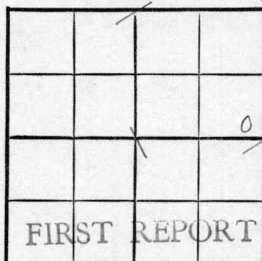

Stafford

Phillips Farmout Shell

Location X

Rig up \_\_\_\_\_

Drilling and Remarks:

## RECORD

DEM

Cased \_\_\_\_\_ in., \_\_\_\_\_ ft.

Sand \_\_\_\_\_

Gas \_\_\_\_\_

Oil \_\_\_\_\_

Total Depth \_\_\_\_\_

## PRODUCTION

1st 24 hrs. Nat. \_\_\_\_\_

1st 24 hrs. after shot \_\_\_\_\_

Gas \_\_\_\_\_ Cu. Ft.

Dry Hole \_\_\_\_\_

Abandoned \_\_\_\_\_

Date

JUN 7 1950 19J. E. TYRA Scout

Kansas

Map No. \_\_\_\_\_ Sec. 22 Twp. 24 R. 14WWell No. 1 Stromer\_\_\_\_\_  
M. B. Armer Company\_\_\_\_\_  
Contractor

SE SE NE

El. 1940

## SECTION PLAT

\_\_\_\_\_  
Ft. from N. Line330 Ft. from S. Line330 Ft. from E. Line\_\_\_\_\_  
Ft. from W. LineStafford County

Location \_\_\_\_\_

Rig up \_\_\_\_\_

Drilling and Remarks:

8" @ 356

Anhy 858

Skid rig 40' west

8" @ 220

Anhy 835

Br. lime 3616

## RECORD

Cased \_\_\_\_\_ in., \_\_\_\_\_ ft.

Sand \_\_\_\_\_

Gas \_\_\_\_\_

Oil \_\_\_\_\_

Total Depth 4275

## PRODUCTION

1st 24 hrs. Nat. \_\_\_\_\_

1st 24 hrs. after shot \_\_\_\_\_

Gas \_\_\_\_\_ Cu. Ft.

Dry Hole \_\_\_\_\_

Abandoned \_\_\_\_\_

Date

JUL 12 1950 19 J. E. TYRA Scout

Miss. 4005

Viola 4107

Simp. 4178

Arb. 4221-75098D

D &amp; A




FORM 302 (Rev. 11-10-1960)