

Stafford

KANSAS

SECTION 22 TOWNSHIP 24S RANGE 14W

WELL NO. #1 Suiter

COMPANY Sunray Mid-Continent Oil Co.

		NORTH				NW NW NW	
WEST	0						
		SOUTH					
		EAST					

HOT FILE

Stafford

KANSAS

SEC.	TWP.	R.
22	24 S	14 W

WELL NO.

1 Suiter

FARM

COMPANY

Sunray Mid-Continent (EXPLORATORY)

CONTRACTOR

Stickle Drlg.

N. Richmond Ext.

330

FT. FROM N. LINE

FT. FROM S. LINE


FT. FROM E. LINE

330

FT. FROM W. LINE

of NW/4

NW NW NW

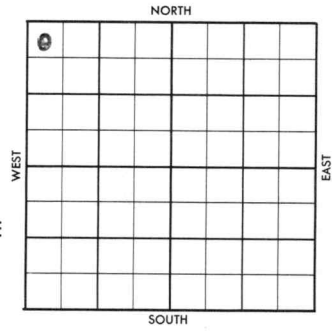

	ELEVATION	REPORT
1957		
	4300'	Arbuckle Test
10/9	Location	(FR Tkt)
10/10	MIRT	(DR#198)
10/11	Spudded 10-10-57	
	TD 300'	WOC. 8-5/8" @ 298'
10/14	Drlg. 2382'	
10/15	Drlg. 2909'	
10/16	Drlg. 3300'	
10/17	Drlg. 3642'	
10/18	TD 3811'	DST 3797-3811'
10/21	Drlg. 4250'	
10/22	TD 4300'	Prep to EL
10/23	TD 4300'	P & A (DR#207)

CO. Stafford ELEV. _____
 SEC. 22 TWP. 24 RGE. 1 ^{**}_W
 COMPANY Sunray Mid-Cont. NO. 1

FIRST REPORT	
OCT 9 '57	

FARM SuiterLOC. NW NW NW

GEOL. _____

CONTR. SticklePOOL N. Richland Ext.

SPUD _____

Location

CO.

LSE.

NO.

SEC.

TWP.

RGE.

Dillwin

S-513-A

CO. Stafford

ELEV. 1970.04

OCT 30 57

SEC. 22

TWP. 24

RGE. 1 W

ABANDONED

Sunray Mid-Cont. No. 1

FARM

Switer

LOC.

SW NW NW

Log TOPS

H 3515

Lsg 3678

Marchant 3957

M 4050

K 4096

V 4148

S Form 4203

SSH 4220

A 4272

LTD 4300

GEOL.

CONTR. Stickle

POOL N. Richland Ext.

SPUD 10-10-57

Location 071837 X

858298/325 ϕ 2909

0723 X H6 3515

Lsg 3679 DST

3791-3811 1hr

rec 15' m

Marchant 3958 Miss 40³⁷ ~~50~~

DST 4036-60 60" Good Bkn

rec 15' m FP 38 BHP 130/30"

K 4099 Viola 4150 S Formation

4203 S Sh. 4222 S sdy Sh

4235 Arb 4272 ϕ 4285

X RTD 4300 ~~cond m 4000~~

Log TOPS

D6A

CO.

LSE.

NO.

SEC.

TWP.

RGE.