


Section 22 Township 24 Range 14W
Well No. #1 White "B"
Company Geo. Seigrist

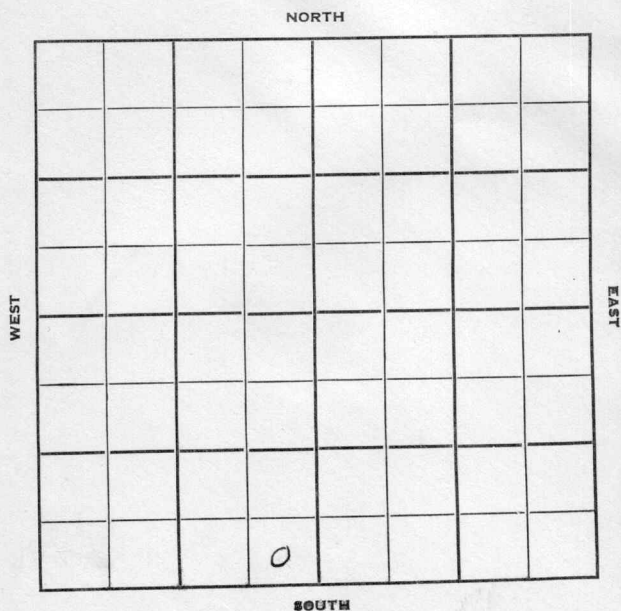

Sec. 22 Twp. 24 R. 14W

Well No. #1 White "B" Farm

Geo. Seigrist

Company

Richland Pool

Contractor

Ft. from N. Line

330'


Ft. from S. Line

330'

Ft. from E. Line

Ft. from W. Line

SE SE SW

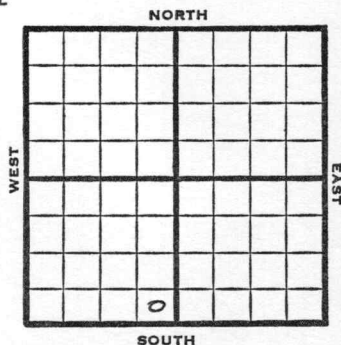

1950 Elev. 1964' REPORT

5/3 Spud 4-29-50
8" @ 250'
Anhy 875'
Drlg. 1260'

7/5 8" @ 250'
Anhy 875'
Br Lime 3635'
Lans. 3652'
DST 3780-3840 opn 1 hr
Rec. 90' OCM
TD 4211'
Miss 4022' Viola 4092
Simp 4167' Arb. 4201'
5 1/2" @ 4203 TD 4211'
PB 4152'
24/3814-37
Acid 1000 HFW
Set plug 3800
4/3783-85
8/3789-92
FU 3300' wtr SSO
Sq. all perf.
CO to 4211
S/100 bf 8 hr (65 BO)
Compl 35 BOPD & 50% wtr.

COMPLETED

Map No. _____ Sec. 22 Twp. 24 R. 14WWell No. 1 White "B"

Geo. Seigrist _____ Company

Contractor

SE SE SW

SECTION PLAT

_____ Ft. from N. Line

330 _____ Ft. from S. Line330 _____ Ft. from E. Line

_____ Ft. from W. Line



Stafford County

Location _____

Rig up _____

Drilling and Remarks:

Spud 4-29-50

8" @ 250

Anhy 875

drlg. 1260

RECORD

Cased _____ in., _____ ft.

Sand _____

Gas _____

Oil _____

Total Depth _____

PRODUCTION

1st 24 hrs. Nat. _____

1st 24 hrs. after shot _____

Gas _____ Cu. Ft.

Dry Hole _____

Abandoned _____

Date

MAY 3 1950 19

J. E. TYRA

Scout

Kansas

Map No. _____ Sec. 22 Twp. 24 R. 14WWell No. 1 White "B"

Geo. Seigrist _____ Company

Contractor

SE SESW


El. 1964

SECTION PLAT

_____ Ft. from N. Line

330 Ft. from S. Line330 Ft. from E. Line

_____ Ft. from W. Line

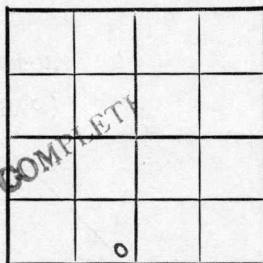

Stafford County

Location _____

Rig up _____

Drilling and Remarks:

8" @ 250

Anhy 875

Br. lime 3635

Lans. 3652

DST 3780-3840

open 1 hr.

Rec. '90' ocm

RECORD

Cased _____ in., _____ ft.

Sand _____

Gas _____

Oil _____

Total Depth 4211

PRODUCTION

1st 24 hrs. Nat. _____

1st 24 hrs. after shot _____

Gas _____ Cu. Ft.

Dry Hole _____

Abandoned _____

Date

JUL 5 1950 19J. E. TYRA

Scout

Miss. 4022

Viola 4092

Simp. 4167

Arb. 4201

5 $\frac{1}{2}$ " © 4203

TD 4211

PB 4152

24/ 3814-36

1000 acid

HFV

set plug 3300

4/ 3783-85

8/ 3789-92

FU 3300' water SSO

Sq. all perf.

CO to 4211

S/ 100 bf 8 hr. (65b $\bar{o}$)

Comp. 35 bopd 50% water

Misc.
Pierce Map
France Map
Tracings
Land Wall Map
Land Small Map
Scout Cards








