Stafford


FORM 51 10M 2-49 PETROL O.W.W.O. KANSAS

Section 22 Township 24 Range 14-W

Well No. #1 White

Company Alpine Oil & Royalty

Richland Pool

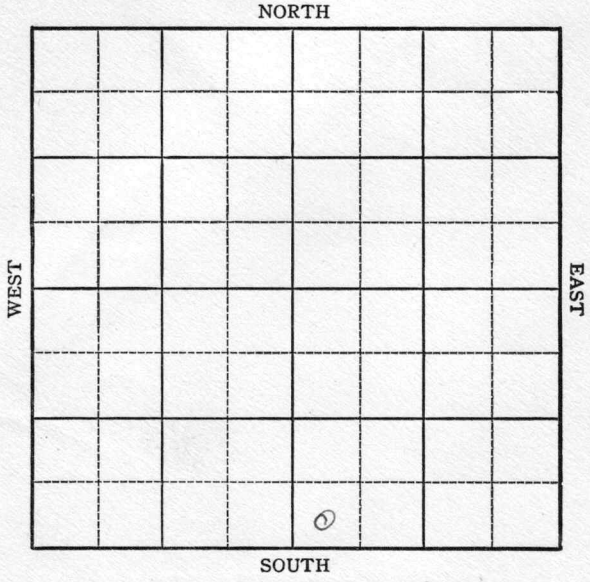

FORM 252-A
5M 10-48 PETROL

Stafford KANSAS

Sec. 22 Twp. 24 R. 14W

Well No. #1 White Farm

Alpine Oil & Royalty Company

Richland (Seigrist, Contr.)
Pool

O.W.W.O.


_____ Ft. from N. Line

330' Ft. from S. Line

_____ Ft. from E. Line

330' Ft. from W. Line

SW SE

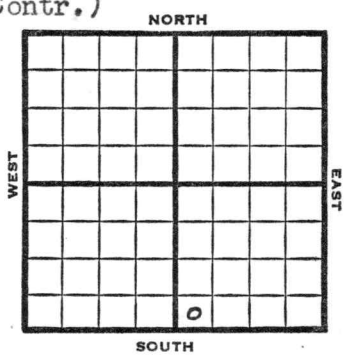

1949	Elev 1970' REPORT
11/23	Location
11/29	"
12/7	8"@ 350 Drlg 2761'
12/14	Lansing 3668' Drlg. 3766'
12/21	Viola 4118' Simpson 4176' Arb. 4219' TD 4229 5"@ 4221'
12/28	"
1950 3/8	TD 4228' 8"@ 350' 5"@ 4221' Miss 4034' Viola 4118' Simp 4176' Arb 4219' 50 BOPD Comp
	COMPLETED O.W.W.O.
1950 5/17	Arb. 4219' KC 3668' 5" @ 4221' OTD 4228' Perf. K.C.

OVER

1950

7/5 Arb. 4219'
KC 3668'
5" @ 4221'
OTD 4228'
25/3781-88'
500 acid
3300' wtr.
TD 4228'
Sq. off
CO to 4228 TD
Pump 35 BO 20 BW PD
Comp. 20 BOPD & 50% wtr.

COMPLETED

Form 26 200 Bks. 6-49 Petrol

Kansas

Richland Pool

Map No. _____ Sec. 22 Twp. 24 R. 14W

Well No. 1 White


Alpine Oil & Royalty Company

Seigrist Contractor

SW SE

FIRST REPORT

SECTION PLAT

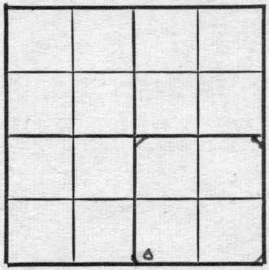

_____ Ft. from N. Line

330 Ft. from S. Line

_____ Ft. from E. Line

330 Ft. from W. Line

Stafford County

Location x

Rig up

Drilling and Remarks:

RECORD

Cased _____ in., _____ ft.

Sand

Gas

Oil

Total Depth

PRODUCTION

1st 24 hrs. Nat.

1st 24 hrs. after shot

Gas _____ Cu. Ft.

Dry Hole

Abandoned

Date

NOV 23 1949 19

S. J. LEWIS Scout

Form 26 200 Bks. 11-49 Petrol

Kansas

Richland Pool

Map No. _____ Sec. 22 Twp. 24 R. 14W

Well No. 1 White


Alpine Oil & Royalty Company

Contractor

SW SE

El. 1970

SECTION PLAT

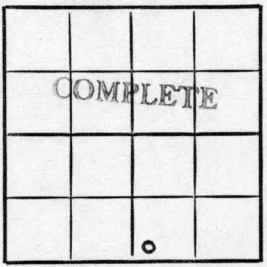

_____ Ft. from N. Line

330 Ft. from S. Line

_____ Ft. from E. Line

330 Ft. from W. Line

Stafford County

Location _____

Rig up _____

Drilling and Remarks:

8" @ 350

5" @ 4221

Miss 4034

Viola 4118

Simp 4176

Arb 4219

RECORD

Cased _____ in., _____ ft.

Sand _____

Gas _____

Oil _____

Total Depth 4228

PRODUCTION

1st 24 hrs. Nat. _____

1st 24 hrs. after shot _____

Gas _____ Cu. Ft.

Dry Hole _____

Abandoned _____

50 BOPD

Date

MAR 8 1950 19

J. E. TYRA

Scout

Form 26 200 Bks. 11-49 Petrol Kansas

Map No. _____ Sec. 22 Twp. 24 R. 14W

Well No. 1 White

Slpine Oil etal Company

_____ Contractor

SW SW SE O.W.W.O. El. 1970

SECTION PLAT

_____ Ft. from N. Line

330 Ft. from S. Line

_____ Ft. from E. Line

330 Ft. from W. Line



Stafford

Location _____

Rig up _____

Drilling and Remarks:

Arb. 4219
K. C. 3668
5" @ 4221
OT.D.4228

Perf. K. C.

RECORD

Cased _____ in., _____ ft.

Sand _____

Gas _____

Oil _____

Total Depth _____

PRODUCTION

1st 24 hrs. Nat. _____

1st 24 hrs. after shot _____

Gas _____ Cu. Ft.

Dry Hole _____

Abandoned _____

Date

MAY 17 1950

_____ 19 J. E. TYRA Scout

Form 26 200 Bks. 11-49 Petrol

OWWO

Kansas

Map No. ____ Sec. 22 Twp. 24 R. 14W

Well No. 1 White


Alpine Oil etal.
Company

Contractor

SW SW SE

El. 1970

SECTION PLAT

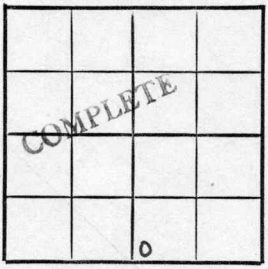

____ Ft. from N. Line

330 Ft. from S. Line

____ Ft. from E. Line

330 Ft. from W. Line

Stafford County

Location

Rig up

Drilling and Remarks:

Arb. 4219
KC 3668
5" @ 4221
OTD 4228
- - - - - - - -
25/ 3781-88
500 acid
3300' water

RECORD

Cased ____ in., ____ ft.
Sand
Gas
Oil
Total Depth 4228

PRODUCTION

1st 24 hrs. Nat.
1st 24 hrs. after shot
Gas ____ Cu. Ft.
Dry Hole
Abandoned

Date

JUL 5 1950

19 J. E. TYRA Scout

SQ. off

CO to 4228 TD

Pump. 35 bo 20 bwpd

Comp. 20 bopd + 50% water

Scout Cards
Land Small Map
Land Wall Map
Tracings
France Map
Pierce Map
Misc.

JUL 7 1950

