


Section 22 Township 24 Range 16W

Well No. #1 Skalsky

Company Branine & Holl

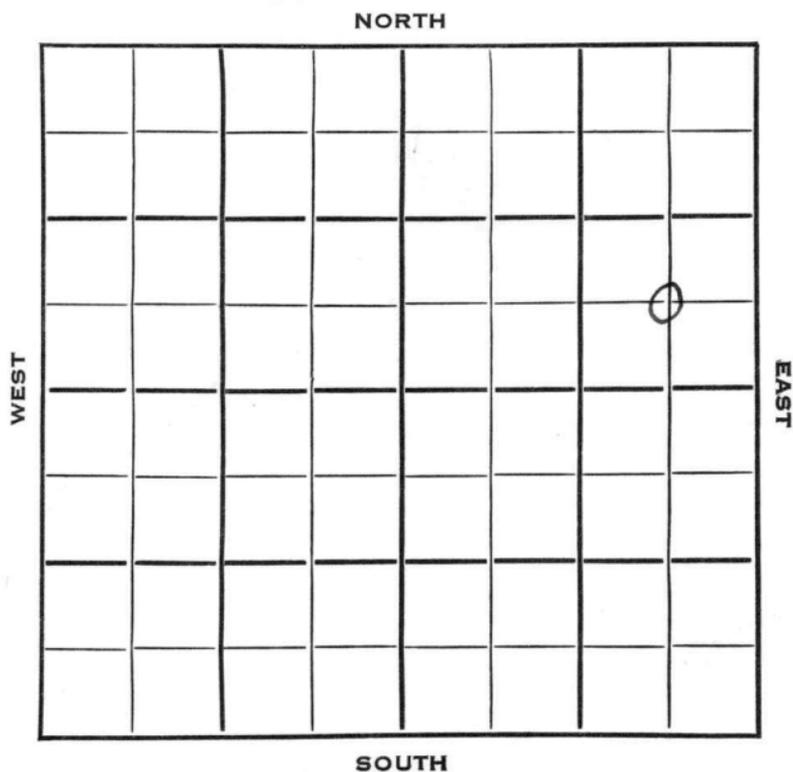

SEC. 22	TWP. 24	R. 16W
---------	---------	--------


WELL NO. #1 Skalsky FARM

COMPANY Branine & Holl

CONTRACTOR Herndon Drlg.

Embry Pool

\_\_\_\_\_ Ft. from N. Line  
 660 \_\_\_\_\_ Ft. from S. Line  
 660 \_\_\_\_\_ Ft. from E. Line  
 \_\_\_\_\_ Ft. from W. Line

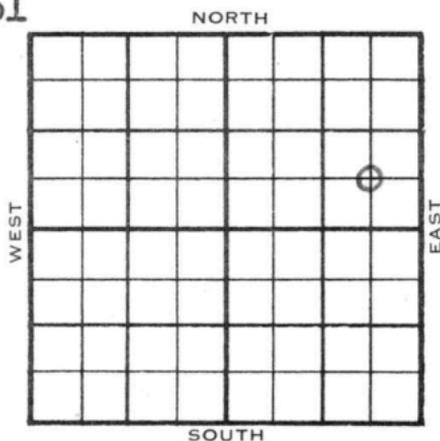

C SE NE

	ELEVATION	REPORT
1953	2066'	
9/30	Spud 9-21-53 8" @ 312' Anhy 1110' Drlg 3700'	
10/7	Lans 3800, Miss 4219, Meisner 4267, DST 4249'-4309' 1 hr, 80' Hly ocm 670# V. 4344	
10/14	Drlg 4511' DST 3805'-70' 1 hr, 540' gas, 450' Ho & gcm, DST 4203'-48' 1 hr, 810' gas, 365' gcm 1300#	
11/11	Spud 9-21-53 Oil well TD 4584 8" @ 312 Anhy 1110 Lans 3800 Miss 4219 Kh. 4235 Meisener 4267 DST 4249-4309 open 1 hr rec 80' HOCM 670# Viola 4344 DST 3805-70 open 1 hr rec 540' gas, 450' Ho & GCM DST 4203-48 open 1 hr rec 810' gas, 365' GCM 1300# Simp 4486 Arb. 4547 TD 4584 5" @ 4340 24/3800-06 24/3824-35 34/BO 3 hr. 1000 A S/4 1/2 BO 1 1/2 BWPH S/2 BO 1/2 BW PH 14 hr. 1250# 5 1/2 BO 4 1/2 BWPH 12 hr Comp. 109 BOPD 45% wtr.	

4217  
2066  
44

O.W.W.O.

Edwards

KANSAS

SEC.

22

TWP.

24

R.

16W

WELL NO.

#1 Skalsky

FARM

COMPANY

Branine & Holl

CONTRACTOR

Embry


FT. FROM N. LINE

FT. FROM S. LINE

FT. FROM E. LINE

FT. FROM W. LINE

C SE NE

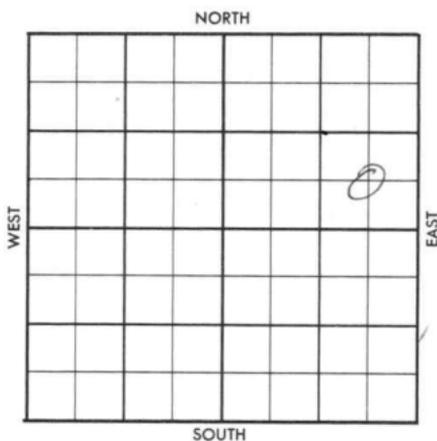

1956

ELEVATION

REPORT

O.W.W.O.

NO-RECORD

6-13-

OTD 4584

5" @ 4340

36/4254-60

A-frac, lost load

Install separator

KC. 3800'; M. 4215'; V. 4340';

S. 4486'; A. 4547';

7-11

ga 4.100 MCF

SITP 1275#.

TD4584'

COMPLETED





O.W.W.O.

FORM 513 SUNRAY

**OWWO**

County Edwards Elev. \_\_\_\_\_  
 Sec. 22 Twp. 24 Rge. 16W  
 Company Bramine & Holl  
 Farm Name Skalsky No. 1

TOPS	DEPTH	LOG	DATUM	Loc. in Sec.				
Anh.				C SE NE				
Tp.								
H.								
Tr.								
Dg.				Geol. _____				
Bl.								
L.				Contr. _____				
M.C.	3800							
B.K.C.				Pool _____				
Ce.								
C.				Embrey				
M.								
M.	4215			<table border="1"> <tr> <td colspan="2">JUN 13 1955</td> </tr> <tr> <td></td> <td>0</td> </tr> </table>	JUN 13 1955			0
JUN 13 1955								
	0							
K.								
Mz.								
Me.								
V.	4340							
S.	4486							
S.	4547			FIRST REPORT				
A.								
R.								
PE.								
G.								
T.D.								

Date Comm. OTD 4584 5" @ 4340 3 6/ 42 54-60  
A-frac lost load install separator

JUL 5 1955

**NO RECORD**

OWJO

County Edwards Elev. \_\_\_\_\_  
 Sec. 22 Twp. 24 Rge. 16W  
 Company Pranine & Noll  
 Farm Name Skalsky No. 1

TOPS	DEPTH	LOG	DATUM	Loc. in Sec.						
Anh.				C SW NE						
TP.										
H.										
Tr.										
Dg.				Geol.						
Bl.										
L.				Conr.						
K.C.	3800									
B.K.C.				Pool						
Ce.										
C.				Embry						
M.										
M.	7215			<table border="1"> <tr> <td></td> <td></td> <td></td> </tr> <tr> <td></td> <td></td> <td>o</td> </tr> </table>						o
		o								
K.										
Mz.										
Me.				<p style="text-align: center; font-weight: bold; font-size: 1.5em;">COMPLETE</p>						
V.	4340									
S.	4486									
S.	4517									
A.				<p style="text-align: center; font-weight: bold; font-size: 1.5em;">COMPLETE</p>						
R.										
PE.				<p style="text-align: center; font-weight: bold; font-size: 1.5em;">COMPLETE</p>						
G.										
TD.	4584									

Date Comm. JUL 1 1 1956  
OTD 4584 5" @ 4340 3 6/42 54-60  
A-frac lost load install separator  
JUN 28 '56 JUN 27 '56 JUL 3 '56 JUL 11 '56 ga  
4,100 MCF SITP 1275

Co.  
No.  
Sec.  
T.  
R.