


KANSAS

FORM 51 IOM-12-46 PETROL

Section 22 Township 24 Range 35-W

Well No. #1 Whitman-Brennaman

Company Cities Service

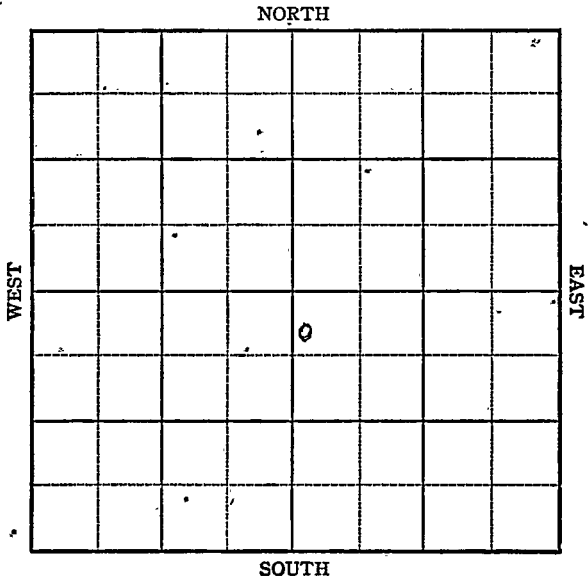

KANSAS

Hugoton Pool

Sec. 22 Twp. 24 R. 35-W

Well No. 1 Whitman-Brennamen Farm

Cities Service Company


NW SE

450 Ft. from N. Line

 Ft. from S. Line

 Ft. from E. Line

100 Ft. from W. Line

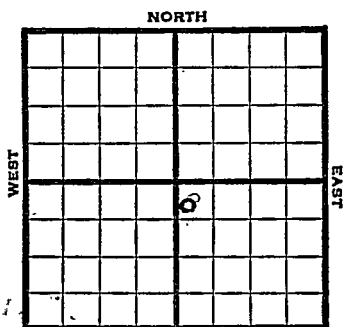

Kearny County Elev. 2957' SOUTH

1947

REPORT

2-12 Location

2/19 8" @ 800 WOC

2/26 TD 2630
5" @ 2629'
RUST

3/4 TD 2630'

3/11 TD 2530'

3/18 140 shots 2540-68
90 shots 2442-2500
90 shots 2420-38

3/25 " "

4/2 " "

4/9 5" @ 2629'
Perf
27,000 Acid
22,800,000 Gas
421# RPr
TD 2630'

COMPLETED

Map No. _____ Sec. 22 Twp. 24 R. 35W

Well No. 1 Whitman-Brennamen

Cities Service

Company

FIRST REPORT

Contractor

NW SE


SECTION PLAT

450 Ft. from N. Line

_____ Ft. from S. Line

_____ Ft. from E. Line

100 Ft. from W. Line

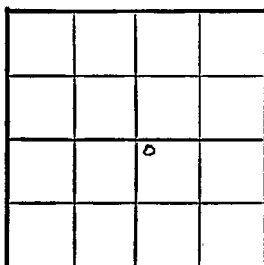

Kearny County

Location X

Rig up

Drilling and Remarks:

RECORD

Cased _____ in., _____ ft.

Sand _____

Gas _____

Oil _____

Total Depth _____

PRODUCTION

1st 24 hrs. Nat. _____

1st 24 hrs. after shot _____

Gas _____ Cu. Ft.

Dry Hole _____

Abandoned _____

Date

FEB 12 1947

19

S. J. LEWIS

Scout

Kansas

Hugoton Pool

Map No. _____ Sec. 22 Twp. 24 R. 35WWell No. 1 Whitman-Brennaman

Cities Service

Company

COMPLETE

Contractor

NW SE


E12857

SECTION PLAT

450 Ft. from N. Line

_____ Ft. from S. Line

_____ Ft. from E. Line

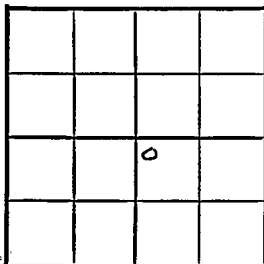100 Ft. from W. Line

Kearny County

Location _____

Rig up _____

Drilling and Remarks:

5' @ 2629

Prof.

27000 acid

22,800,000 Gas.

431 # R/A

RECORD

Cased _____ in., _____ ft.

Sand _____

Gas _____

Oil _____

Total Depth 2630

PRODUCTION

1st 24 hrs. Nat. _____

1st 24 hrs. after shot _____

Gas _____ Cu. Ft.

Dry Hole _____

Abandoned _____

Date

APR 9 1947 19

S. J. LEWIS

Scout