

Stafford

KANSAS

Section 23 Township 24 Range 11-W

Well No. 7 U. G. Ferris "B"

Company Stanolind et al

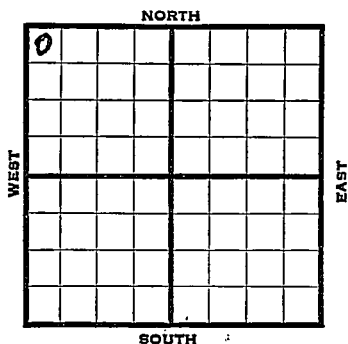
NORTH Zenith Pool

KANSAS

Stafford

Sec. 23 Twp. 24 R. 11-WWell No. #7 U. G. Ferris "B" FarmStanolind et al Company

(Zenith)

330 Ft. from N. Line Ft. from S. Line Ft. from E. Line330 Ft. from W. Line

Elev. 1820

1939	REPORT
1/18	Cellar.
1/27	R.U.R.
2/3	10" - 252'. Drlg. 2195'.
2/10	Drlg. 3717'.
2/17	Base Kind. 3801' T.D. 3810'
	7" - 3802' RUST.
2/23	Drilled plug. T.D. 3810'
	Flow 89 oil in 5 hrs. S.W.
	2000 acid. Flow 19 oil per hr. for 8 hrs.
3/1	7" - 3802'
	Misener Dolomite, no top determined.
	T. D. 3810'
	2000 acid.
	Potential 153 bbls. on pump.
	Made 8 water per hour.
	COMPLETED

Stafford **KANSAS**Map No. _____ Sec. 23 Twp. 24 R. 11WWell No. 7 U. G. Ferris "B"Stanolind etal Company

Contractor

FIRST REPORT

NW/C

330 Ft. from N. Line

_____ Ft. from S. Line

_____ Ft. from E. Line

330 Ft. from W. Line**SECTION PLAT**

0			

ZENITH POOL

Location _____

Rig up _____

Drilling and Remarks:

Cellar**RECORD**

Cased _____ in., _____ ft.

Sand _____

Gas _____

Oil _____

Total Depth _____

PRODUCTION

1st 24 hrs. Nat. _____

1st 24 hrs. after shot _____

Gas _____ Cu. Ft.

Dry Hole _____

Abandoned _____

Date

JAN 18 1939

19

H. D. Hatfield

Scout

KANSAS

Stafford

Map No. 47 Sec. 23 Twp. 24 R. 11WWell No. 7 U. G. Ferris "B"Stanolind etal Company

Contractor

COMPLETED

NW/C

330 Ft. from N. Line Ft. from S. Line Ft. from E. Line330 Ft. from W. Line

ZENITH POOL

SECTION PLAT

0			

Location Rig up

Drilling and Remarks:

2000 AcidPOT 153PumpMade 8 wtr P.H.

RECORD

Cased 7 in., 3802 ft.Sand Misener DolomiteGas No top determinedOil Total Depth 3810

PRODUCTION

1st 24 hrs. Nat. 1st 24 hrs. after shot Gas Cu. Ft.Dry Hole Abandoned

Date

MAR 1 - 1939 19H. D. Hatfield Scout