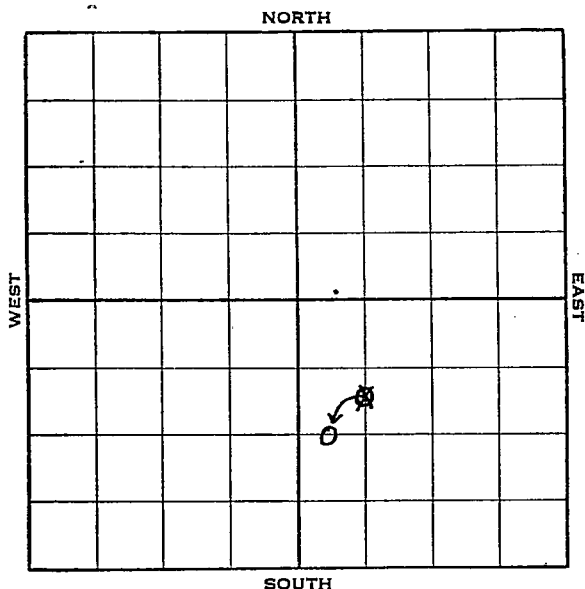


Stafford

KANSAS

re "


Section 23 Township 24 Range 11-WWell No. #4 Mary HartnettCompany Stanolind et al

KANSAS

Stafford -

Sec. 23 Twp. 24 R. 11-WWell No. #4 Mary Martnett FarmStanolind et al Company

NORTH

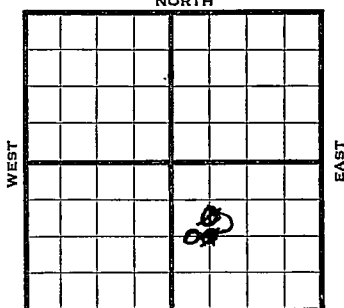~~990~~ Ft. from N. Line1320 Ft. from S. Line

Ft. from E. Line

330~~660~~ Ft. from W. Line

Elev. 1798'.

1938	REPORT
9/28	Location
10/7	Cellar.
10/14	"
10/21	"
10/28	"
11/4	"
11/12	"
11/18	10" - 233'. WOC.
11/25	Dlg. 2945'.
12/2	Misener 3802'. Sat. 3802-13'T.D.
	7" - 3803'. RUST.
12/9	T. D. 3813'. Flow 11 oil in 3 hours.
12/13	7" - 3803'.
	Misener 3802'.
	T. D. 3813'.
	Potential 1107 bbls., Nat'l.
	COMPLETED

Map No. 47 Sec. 23 Twp. 24 R. 11WWell No. 4 Mary HartnettStanolind etal Company

Contractor

FIRST REPORT

C S L NW SE

990 Ft. from N. Line Ft. from S. Line Ft. from E. Line660 Ft. from W. Line

SECTION PLAT

		0	

Location XRig up

Drilling and Remarks:

RECORD

Cased in., ft.Sand Gas Oil Total Depth

PRODUCTION

1st 24 hrs. Nat. 1st 24 hrs. after shot Gas Cu. Ft.Dry Hole Abandoned

Date

SEP 28 19H. D. Hatfield Scout

Stafford KANSAS

Map No. 47 Sec. 23 Twp. 24 R. 11 WWell No. 4 - Mary HartnettStano et al Company

Contractor

CW LSE

SECTION PLAT

CORRECTION

		02	

_____ Ft. from N. Line

1320 Ft. from S. Line

_____ Ft. from E. Line

330 Ft. from W. Line

CORRECTION

Location _____

Rig up _____

Drilling and Remarks:

1st reported asCSL NW SE

RECORD

Cased _____ in., _____ ft.

Sand _____

Gas _____

Oil _____

Total Depth _____

PRODUCTION

1st 24 hrs. Nat. _____

1st 24 hrs. after shot _____

Gas _____ Cu. Ft.

Dry Hole _____

Abandoned _____

Date

OCT 5 - 1938

19

H. D. Hatfield Scout

Stafford

KANSAS

Map No. 47 Sec. 23 Twp. 24 R. 11WWell No. 4 Mary HartnettStanolind etal

Company

Contractor

COMPLETED

C W L SE

 Ft. from N. Line1320 Ft. from S. Line Ft. from E. Line330 Ft. from W. Line

SECTION PLAT

		0	

Location Rig up

Drilling and Remarks:

RECORD

Cased 7 in., 380.3 ft.Sand Misener 3802Gas Oil Total Depth 381.3

PRODUCTION

1st 24 hrs. Nat. 1st 24 hrs. after shot Gas Cu. Ft.Dry Hole Abandoned

Date

DEC 13 1938 19

H. D. Hatfield

Scout

Pot 1107
N2T