


Section 23 Township 24 Range 11-W

Well No. 4 Mamie Volker "A"

Company Stanolind et al

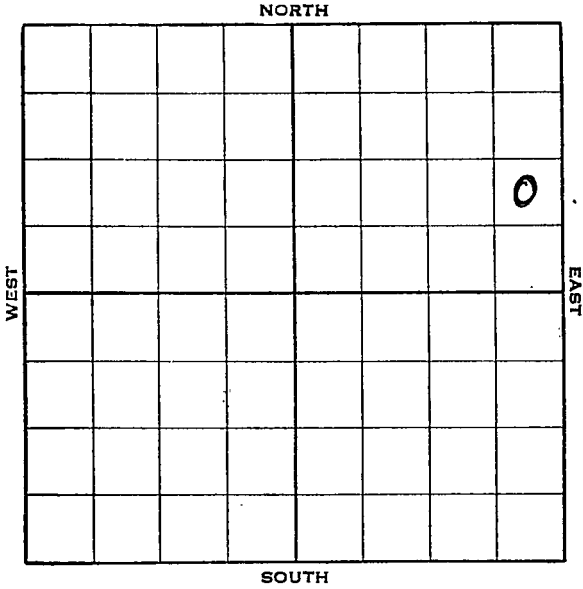

KANSAS

Stafford


Sec. 23 Twp. 24 R. 11-WWell No. #4 Mamie Volker "A" FarmStanolind et al Company

Ft. from N. Line

990 Ft. from S. Line330 Ft. from E. Line

Ft. from W. Line

Elev. 1805'.

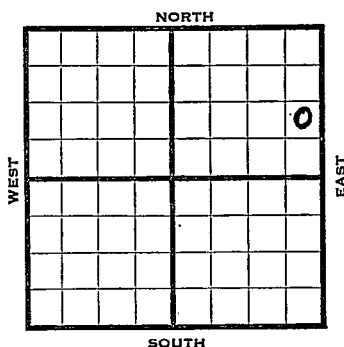

1938	REPORT
6/8	Location
6/17	B.R.R.
6/24	13" *254'. WOC.
7/1	Drig. 2614'.
7/8	Base Kinderhook 3793'.
	T. D. 3795'. Rng. 6".
7/15	3795' equals 3792'.
	6" - 3790'.
	Base Kinderhook 3790'.
	Misner 3790'. Sat. sand, 3792-97
	Viola 3805'. T. D. 3810' C. O.
7/20	6" - 3790'.
	Misner 3790'.
	Viola 3805'.
	T. D. 3810'.
	Flowed 318 bbls. 4 hrs. & 318
	bbls. 4 hrs.
	Potential 1910 bbls.
	COMPLETED

Stafford KANSAS

Map No. 47 Sec. 23 Twp. 24 R. 11WWell No. 4 Mamie Volker "A"Stanolind etal

Company

Contractor

FIRST REPORT

NE SE NE

Ft. from N. Line

990 Ft. from S. Line330 Ft. from E. Line

Ft. from W. Line

SECTION PLAT

			0

Location X

Rig up

Drilling and Remarks:

RECORD

Cased _____ in., _____ ft.

Sand _____

Gas _____

Oil _____

Total Depth _____

PRODUCTION

1st 24 hrs. Nat. _____

1st 24 hrs. after shot _____

Gas _____ Cu. Ft.

Dry Hole _____

Abandoned _____

Date

JUN 8 - 1933 19

H. D. Hatfield Scout

Stafford KANSAS

Map No. 47 Sec. 23 Twp. 24 R. 11WWell No. 4 Mamie Volker "A"Stanolind etal Company

Contractor

COMPLETED

SECTION PLAT

		.	0

NE SE NE

Ft. from N. Line

990 Ft. from S. Line330 Ft. from E. Line

Ft. from W. Line

Location _____

Rig up _____

Drilling and Remarks:

Flowed
 $318/4 + 318/4$
 POT 1910

RECORD

Cased 6 in., 3790 ft.Sand Misener 3790Gas 41012 3805

Oil _____

Total Depth 3810

PRODUCTION

1st 24 hrs. Nat. _____

1st 24 hrs. after shot _____

Gas _____ Cu. Ft.

Dry Hole _____

Abandoned _____

Date

JUL 20 1938 19 H. D. Hatfield Scout