


Section 23 Township 24 Range 11-W

Well No. #1 Nannie Voaker

Company Starolind et al

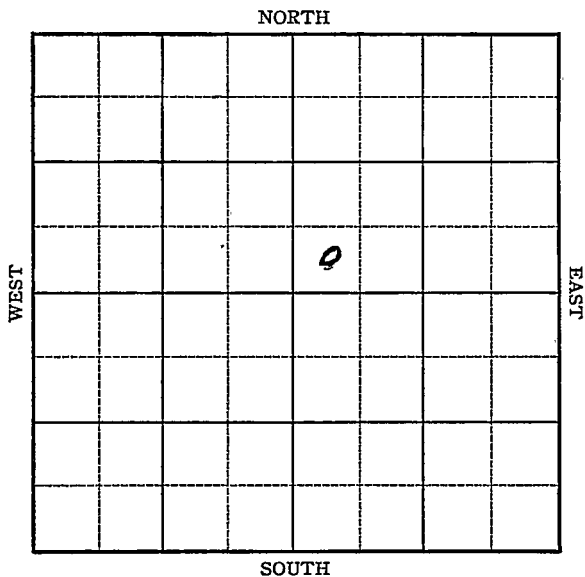

Sec. 23 Twp. 24 R. 11-W

Well No. #1 Nannie Voaker Farm

Stanolind et al Company


\_\_\_\_\_ Ft. from N. Line

330 Ft. from S. Line

\_\_\_\_\_ Ft. from E. Line

330 Ft. from W. Line

Elev. 1806

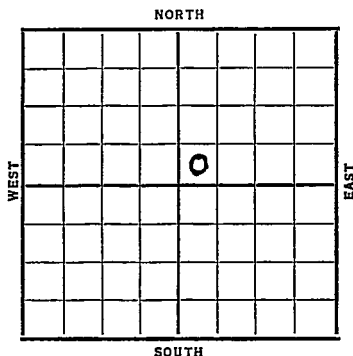

Date	REPORT
1937	
9/22	B. R. R.
10/2	10" @ 254'. Drlg. 1410'.
10/8	Drlg. 3040'.
10/15	Lansing 3390'.
	Simp. sand 3790'. T.D. 3801'.
	Sat. Core. 7" @ 3790'.
10/22	" " " "
10/29	Flowed 91 bbls. oil 1st hr.
	Est. 3 M gas.
11/3	7" @ 3790'.
	Simpson 3790'.
	T.D. 3801'.
	Potential 1922 bbls., Flowing.
	<b>COMPLETED</b>

*Stafford* KANSAS

Map No. 47 Sec. 23 Twp. 24 R. 1125

Well No. 1 *Nannie Woakes*

*Stanaland et al.* Company

Contractor

**FIRST REPORT**

**SECTION PLAT**

\_\_\_\_\_ Ft. from N. Line  
330 Ft. from S. Line  
 \_\_\_\_\_ Ft. from E. Line  
330 Ft. from W. Line

		0	

Location \_\_\_\_\_

Rig up \_\_\_\_\_

Drilling and Remarks:

*P.P.R.*

**RECORD**

Cased \_\_\_\_\_ in., \_\_\_\_\_ ft.  
 Sand \_\_\_\_\_  
 Gas \_\_\_\_\_  
 Oil \_\_\_\_\_  
 Total Depth \_\_\_\_\_

**PRODUCTION**

1st 24 hrs. Nat. \_\_\_\_\_  
 1st 24 hrs. after shot \_\_\_\_\_  
 Gas \_\_\_\_\_ Cu. Ft.  
 Dry Hole \_\_\_\_\_  
 Abandoned \_\_\_\_\_

Date

SEP 22 1937<sub>19</sub>

*H. D. Hatfield*

Scout

Stafford **KANSAS**

Map No. 47 Sec. 23 Twp. 24 R11W

Well No. 1 Nannie Voaker

Stanolind etal Company

Contractor

**COMPLETED**

**SW NE**

         Ft. from N. Line

330 Ft. from S. Line

         Ft. from E. Line

330 Ft. from W. Line

**SECTION PLAT**

		0	

Location                                 

Rig up                                 

Drilling and Remarks:

*POT-1922*

*Flowing*

**RECORD**

Cased 7 in., 3790 ft.

Sand Simpson 3790

Gas                                 

Oil                                 

Total Depth 3801

**PRODUCTION**

1st 24 hrs. Nat.                         

1st 24 hrs. after shot                         

Gas                                  Cu. Ft.

Dry Hole                                 

Abandoned                                 

Date

NOV 3 1937 19

H. D. Hatfield Scout