


Stafford

KANSAS

Section 23 Township 24 Range 11-W

Well No. 2 W. C. Volker

Company Stanolind et al

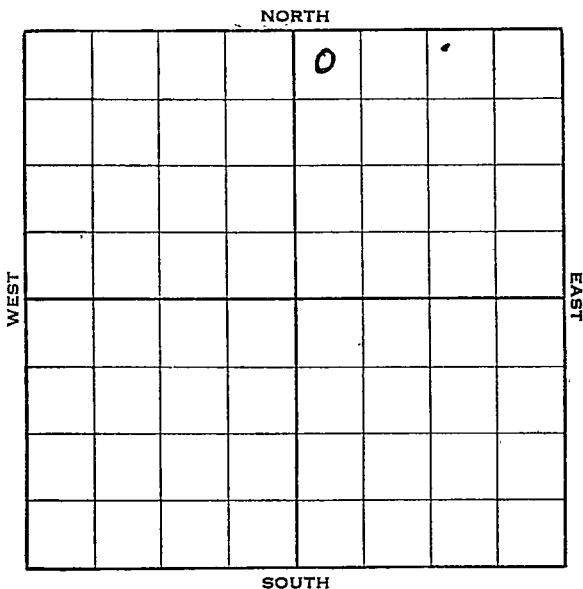

KANSAS

stafford


Sec. 23 Twp. 24 R. 11-WWell No. #2 W. C. Volker FarmStanolind et al Company330 Ft. from N. Line

Ft. from S. Line

Ft. from E. Line

330 Ft. from W. Line

Elev. 1816

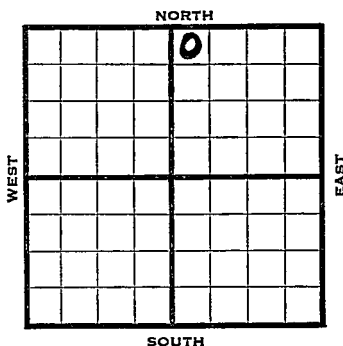

1938	REPORT
3/30	Location
4/8	Cellar.
4/15	R. R.
4/22	"
4/29	10" @ 238'. Drlg. 700'.
5/6	Anhy. 523'. Drlg. 3095'.
5/12	Lans. 3405'.
	Base Kinderhook 3804-05' T.D.
	7" @ 3804'. RUST.
5/20	T.D. 3830'. Cleaning out.
5/25	7" @ 3804'.
	Misner 3805'.
	Viola 3828'.
	T.D. 3830'.
	Potential 2243 bbls.
	Flowing thru 3" tubing.
	COMPLETED

Stafford

KANSAS

Map No. 47 Sec. 23 Twp. 24 R. 11WWell No. 2 W. C. VolkerStanolind etal

Company

Contractor

FIRST REPORT

NW NE

330 Ft. from N. Line Ft. from S. Line Ft. from E. Line330 Ft. from W. Line

SECTION PLAT

		0	

Location XRig up

Drilling and Remarks:

RECORD

Cased in., ft.Sand Gas Oil Total Depth

PRODUCTION

1st 24 hrs. Nat. 1st 24 hrs. after shot Gas Cu. Ft.Dry Hole Abandoned

Date

MAR 30 1938 19

H. D. Hatfield Scout

Stafford KANSAS

Map No. 47 Sec. 23 Twp. 24 R. 11WWell No. 2 W. C. VolkerStanolind et al

Company

Contractor

COMPLETED

NW NE

330 Ft. from N. Line Ft. from S. Line Ft. from E. Line330 Ft. from W. Line**SECTION PLAT**

		0	

Location Rig up Drilling and Remarks: *POT 2243**Flowing Thru
3" Tubing***RECORD**Cased 7 in., 3804 ft.Sand Misener 3805Gas Viola 3828Oil Total Depth 3830**PRODUCTION**1st 24 hrs. Nat. 1st 24 hrs. after shot Gas Cu. Ft.Dry Hole Abandoned

Date

MAY 25 1938

19

H. D. Hatfield

Scout