

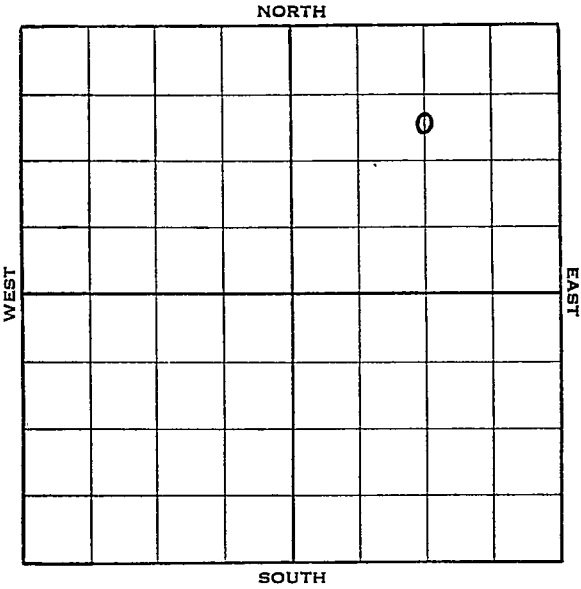
Stafford

KANSAS

Section 23 Township 24 Range 11-W

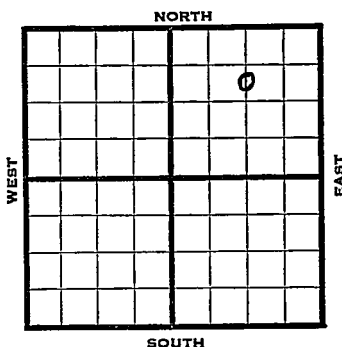
Well No. 7 W. C. Volker

Company Stanolind et al



KANSAS

Stafford

Sec. 23 Twp. 24 R. 11-WWell No. #7 W. C. Volker FarmStanolind et al Company990 Ft. from N. Line Ft. from S. Line1320 Ft. from E. Line Ft. from W. Line

Elev. 1811'.

1938	REPORT
10/5	Cellar.
10/14	13" - 254'. WOG.
10/21	Dlg. 2640'.
10/28	Dlg. 3702'.
11/4	Lans. 3395'. Misener 3798-3800'. 7" - 3798'. RUST.
11/12	Sat. sand 3800-05'. Viola 3806'. T. D. 3807'. Flow 57 oil in 2 hrs. S. W. P. B.
11/18	P. B. 3806'. Shot 10 qts. 3801-05'. Flow 196 oil in 3 hrs.
11/22	7" - 3798'. Misener 3798'. (Viola 3806'). No oil. T. D. 3807' S. W. P. B. to 3806'. Shot 10 qts. Potential 1909 bbls.
	COMPLETED

Stafford KANSAS

Map No. 27 Sec. 23 Twp. 24 R. 11WWell No. 7 W. C. Volker

Stanolind etal

Company

Contractor

FIRST REPORT

990 C S L N $\frac{1}{2}$ NE
Ft. from N. Line

Ft. from S. Line

1320 Ft. from E. Line

Ft. from W. Line

SECTION PLAT

			0

Location

Rig up

Drilling and Remarks:

Cellar

RECORD

Cased _____ in., _____ ft.

Sand _____

Gas _____

Oil _____

Total Depth _____

PRODUCTION

1st 24 hrs. Nat. _____

1st 24 hrs. after shot _____

Gas _____ Cu. Ft.

Dry Hole _____

Abandoned _____

Date

OCT 5 - 1938 19

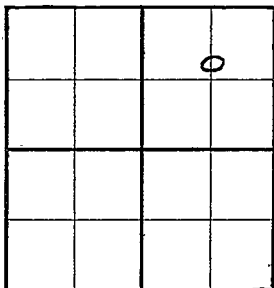
H. D. Hatfield

Scout

Stafford **KANSAS**Map No. 47 Sec. 23 Twp. 24 R. 11WWell No. 7 W. C. VolkerStanolind etal

Company

Contractor

COMPLETED**C S L N $\frac{1}{2}$ NE****SECTION PLAT**990 Ft. from N. Line Ft. from S. Line1320 Ft. from E. Line Ft. from W. LineLocation Rig up

Drilling and Remarks:

PB 3806
shot 10 gts
POT 1909

RECORDCased 7 in., 3798 ft.Sand Misener 3798Gas (Vio/2 3806)Oil No oilTotal Depth 3807**PRODUCTION**1st 24 hrs. Nat. 1st 24 hrs. after shot Gas Cu. Ft.Dry Hole Abandoned

Date

NOV 22 193819H. D. Hatfield Scout