


Stafford
24 *13W*

Map No. **KANSAS** Sec. *23* Twp. *24* R. *13W*

Well No. *1- Bennett* *Benton* Farm
Empire Oil Company

NORTH

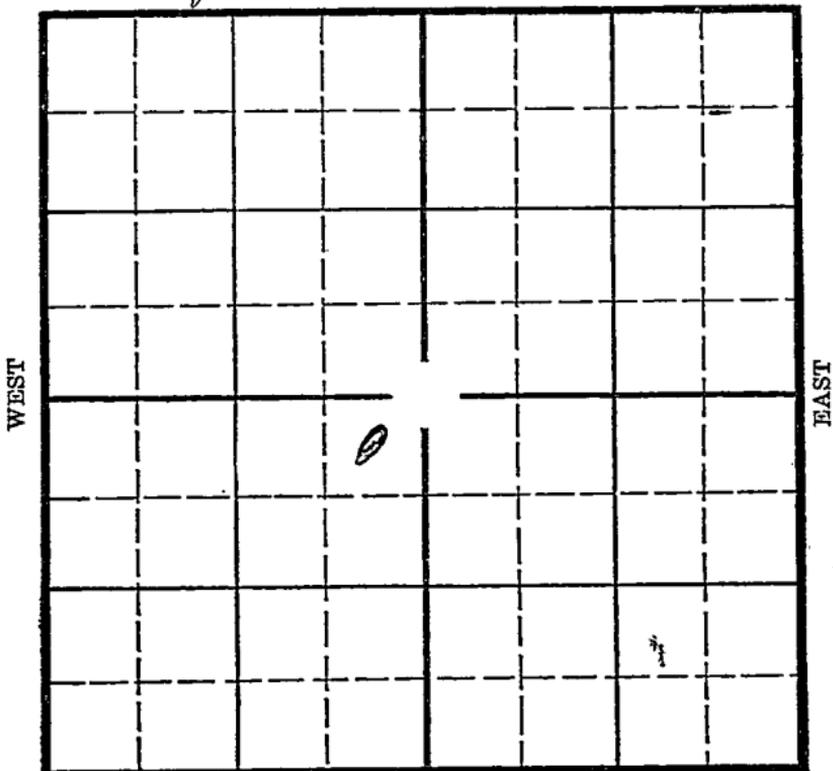

SOUTH

O. W. D. D.

Location _____

Drilling Remarks _____

RECORD

Cased _____ in. _____ ft.

Sand _____

Gas _____

Oil _____

Total Depth _____

Rig Up _____

Drilling Remarks _____

PRODUCTION

1st 24 hrs. Nat. _____

1st 24 hrs. after shot _____

Gas _____ cu. ft. _____

Dry Hole _____

Abandoned _____

KANSAS

Stafford
24 R. 13W

Map No. Sec. 23 Twp. 24 R. 13W

Well No. 1- ~~Bennett~~ Benton Farm

Empire Oil Company


330 Ft. from N. Line

Ft. from S. Line

330 Ft. from E. Line

Ft. from W. Line

Elev. 1916

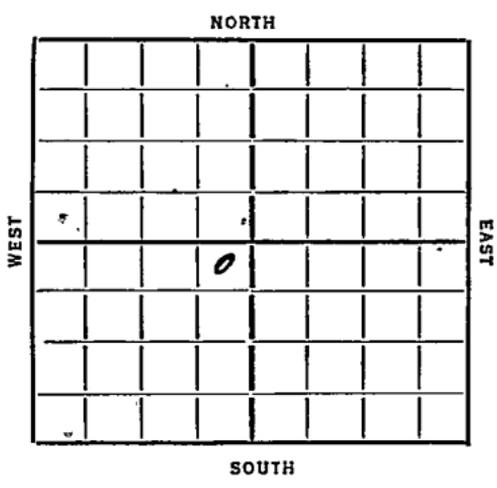

Date REPORT O. W. D. D

12/30 Location
 1/10/36 4M9 Mat
 1/11/7 Run up
 1/24 Olg 1445 12" 310
 1/31 TD 2990 SD Out of wtr
 2/7 TIC 3535
 SD 3555-60 TD 3566
 8" 3550 WOC
 2/14 Olg 3600 400' O.T.H
 2/21 Lams 3539 8" 3558
 Ray 3579-91
 1500' Oil 51 hrs
 TD 3632 800' wtr & lvs
 PB 3620 WOC
 2/28 Testy wtr shut off
 3/6 TD 3620 1000 acid
 pumped 50 oil & 80 wtr
 24 hrs shutting off wtr
 3/18 Lansing 3539 TD 3632
 PB 3620 1000 + 2000 acid
 Pot 270 Oil 10 wtr

COMPLETED

OVER

O. W. D. D

1936

11/4-Old T. D. 3620
Rigging up

11/6---11/12---

11/19 Drlg. 3733 H.F.W. Drlg. 3750'

11/27--Drlg. 3858'.

12/3 7" @ 3873'. Drlg. 3880'.

12/10 7" @ 3884'. Viola 3886'.
Drlg. 3897'.

12/17 7" @ 3892'. T. D. 3900'.
Clean out.

12/24 Drlg. 3985'.

12/29 Simpson 4030'. Drlg. 4063'.

1937

1/7 Sil. 4078'. T. D. 4081'.
Show oil. Underream 7".

1/14 7" @ 4079'. T. D. 4081'. WOC.

1/21 T. D. 4093'. 800 bbls. 23 hrs.

1/28 835 bbls. 24 hrs.

2/3 Sil. 4078'.

T. D. 4093'.

2000 acid.

Potential 960. Trace water.

COMPLETED

1937

O. W. D. D

5/26 O.T.D. 4093'.

5" liner 4093'.

Drlg. 4103'.

6/4 T.D. 4106'. 2000 acid.
Pumped 66 oil per hour.

OVER

1937

6/9 5" liner 4093'.

O.T.D. 4093'.

T.D. 4106'.

2000 acid.

Pot. 1542 oil.

(60 water)

COMPLETED

Map No. 83 Sec. 23 Twp. 24 R. 13W

Well No. 1-Bennett

Empire oil Company

Contractor

FIRST REPORTS

SECTION PLAT

330 Ft. from N. Line

..... Ft. from S. Line

330 Ft. from E. Line

..... Ft. from W. Line

	0		

Location

Rig up.....

Drilling and Remarks:

RECORD

Cased..... in., ft.

Sand.....

Gas.....

Oil.....

Total Depth.....

PRODUCTION

1st 24 hrs. Nat.....

1st 24 hrs. after shot.....

Gas..... Cu. Ft.

Dry Hole.....

Abandoned.....

Date 12-30-35 192.....

ORVAL MANNSCHRECK
Scout

Map No. 83 Sec. 23 Twp. 24 R. 13W

Well No. 1 - Benton

Empire Company

Contractor

NE SW

SECTION PLAT

330 Ft. from N. Line

..... Ft. from S. Line

330 Ft. from E. Line

..... Ft. from W. Line

	0		

CORRECTION

Location.....

Rig up.....

Drilling and Remarks:

*has been carried
as #1 Bennett*

RECORD

Cased..... in., ft.

Sand.....

Gas.....

Oil.....

Total Depth.....

PRODUCTION

1st 24 hrs. Nat.....

1st 24 hrs. after shot.....

Gas..... Cu. Ft.

Dry Hole.....

Abandoned.....

Date

JAN 8 1936

ORVAL MANNSCHRECK

MSAS

Map No. 83 Sec. 23 Twp. 24 R. 13W

Well No. 1 - Benton

Empire Company

Contractor

SECTION PLAT

COMPLETED

330 Ft. from N. Line

..... Ft. from S. Line

330 Ft. from E. Line

..... Ft. from W. Line

	o		

Location.....

Rig up.....

Drilling and Remarks:

*P.B. - 3620
1000 acid
2000 acid
Pot 270 oil
10 water*

RECORD

Cased..... in., ft.

Sand Lansing 3539

Gas.....

Oil.....

Total Depth 3632

PRODUCTION

1st 24 hrs. Nat.

1st 24 hrs. after shot.....

Gas..... Cu. Ft.

Dry Hole.....

Abandoned.....

Date

MAR 18 1936

ORVAL MANNSCHRECK Scout

Map No. 83 Sec. 23 Twp. 24 R. 13W.

Well No. 1 Benton

Empire Company

Contractor

SECTION PLAT

	0		

380 Ft. from N. Line

_____ Ft. from S. Line

380 Ft. from E. Line

_____ Ft. from W. Line

FIRST REPORT

OW 1117

Location _____

Rig up _____

Drilling and Remarks:

Old TD 3620

Rigging up
WJ

RECORD

Cased _____ in., _____ ft.

Sand _____

Gas _____

Oil _____

Total Depth _____

PRODUCTION

1st 24 hrs. Nat. _____

1st 24 hrs. after shot _____

Gas _____ Cu. Ft.

Dry Hole _____

Abandoned _____

Date

NOV 4 1936

S. J. LEWIS

Scout

KANSAS

Map No. 83 Sec. 23 Twp. 24 R. 13W

Well No. 1 Benton

Empire Company

Contractor

SECTION PLAT

	0		

330 Ft. from N. Line

_____ Ft. from S. Line

330 Ft. from E. Line

_____ Ft. from W. Line

COMPLETED

Location _____

Rig up _____

Drilling and Remarks:

Sil 4078
2000 acid
Potential 960"
trace water

RECORD

Cased _____ in., _____ ft.

Sand _____

Gas _____

Oil _____

Total Depth 409.3

PRODUCTION

1st 24 hrs. Nat. _____

1st 24 hrs. after shot _____

Gas _____ Cu. Ft.

Dry Hole _____

Abandoned _____

Date

FEB 3 1937 19

S. J. LEWIS

Scout

Stafford KANSAS

Map No. 83 Sec. 23 Twp. 24 R. 13 W

Well No. 1-Benton

Empire Company
 Contractor

FIRST REPORT

SECTION PLAT

330 Ft. from N. Line
 _____ Ft. from S. Line
330 Ft. from E. Line
 _____ Ft. from W. Line

	0		

OWDD

Location _____

Rig up _____

Drilling and Remarks:

O.T.D. 4093
5" Liner @ 4093
Dlg 4103

RECORD

Cased _____ in., _____ ft.
 Sand _____
 Gas _____
 Oil _____
 Total Depth _____

PRODUCTION

1st 24 hrs. Nat. _____
 1st 24 hrs. after shot _____
 Gas _____ Cu. Ft.
 Dry Hole _____
 Abandoned _____

Date

MAY 26 1887 19

H. D. Hatfield Scout

KANSAS

Form 26 - 11 M. Bks. - 2-29

Stafford

Map No. 83 Sec 28 Twp. 24 R. 13 W

Well No. 1-Benton

Empire Company

Contractor

COMPLETED

330 Ft. from N. Line

Ft. from S. Line

330 Ft. from E. Line

Ft. from W. Line

- O.W.D.D -

SECTION PLAT

	0		

Location

Rig up

Drilling and Remarks:

2000 Acid

Pot 1542 oil

(low water)

RECORD

Cased 5" Liner in., 4093 ft.

Sand

Gas

Oil - Q.T.D. 4093

Total Depth 4106

PRODUCTION

1st 24 hrs. Nat.

1st 24 hrs. after shot

Gas Cu. Ft.

Dry Hole

Abandoned

Date

JUN 9 1937 19

H. D. Hatfield Scout