


Stafford

Section 23 Township 24 Range 13-W

Well Number 3 - Benton

Company Empire

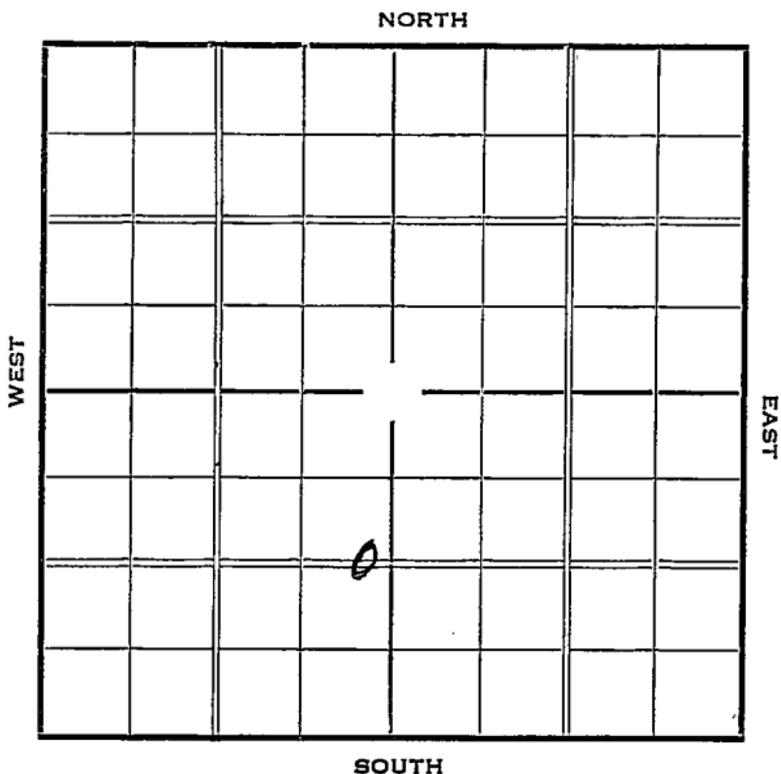

Sec. 23 Twp. 24 R. 13-W

Well No. #3 Benton Farm
Empire Company


 Ft. from N. Line

1320 Ft. from S. Line

330 Ft. from E. Line

 Ft. from W. Line

Elev. 1921

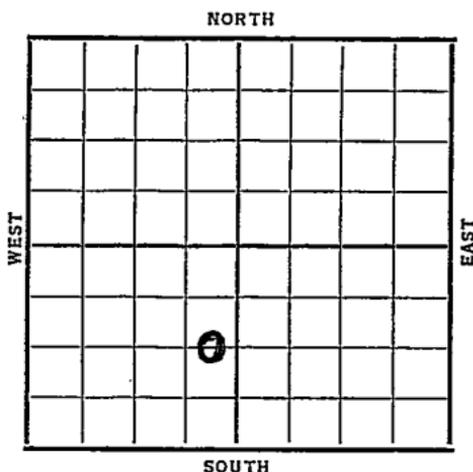

Date	REPORT
1937	
7/14	Location
7/23	B. R. R.
7/30	12" @ 322'. Drlg. 1635'.
8/6	Drlg. 3395'.
8/13	S. O. 3502-3607'.
	Coring 4103'.
8/20	Sil. 4128 & 7". T.D. 4131'.
	RUST.
8/28	"
9/3	T.D. 4133'. No oil.
	99 shots 3718-43'.
	S.O. & Water. 3000 acid.
	Pumped 136 oil & 409 water in 21 hours.
	OVER

1937

9/8

7" @ 4128'.

Sil. 4128'.

T.D. 4133'.

Shot 99 shots.

3000 acid.

P. $7\frac{1}{2}$ B.O. & 493 water 24 hrs.

ABANDONED

Stafford

Map No. _____ Sec. 23 Twp. 24 R. 13 W

Well No. 3-Benton

Empire Company
Contractor

FIRST REPORT

SECTION PLAT

1320 Ft. from N. Line
1320 Ft. from S. Line
330 Ft. from E. Line
_____ Ft. from W. Line

Location ✓

Rig up _____

Drilling and Remarks:

RECORD

Cased _____ in., _____ ft.

Sand _____

Gas _____

Oil _____

Total Depth _____

PRODUCTION

1st 24 hrs. Nat. _____

1st 24 hrs. after shot _____

Gas _____ Cu. Ft.

Dry Hole _____

Abandoned _____

Date

JUL 14 1937 19

H. D. Hatfield Scout

Map No. 83 Sec. 23 Twp. 24 R. 13WWell No. 3-Benton
Empire Oil & R

Company

Contractor

ABANDONED

SECTION PLAT

	0		

 Ft. from N. Line1320 Ft. from S. Line330 Ft. from E. Line Ft. from W. LineLocation Rig up

Drilling and Remarks:

Shot 99 ~~pts~~ shots
3000 acid
p. 7 1/2 B.O. + 493 water
10 + 17

RECORD

Cased 7 in., 4128 ft.Sand Nil 4128Gas Oil Total Depth 4133

PRODUCTION

1st 24 hrs. Nat. 24 hrs1st 24 hrs. after shot Gas Cu. Ft.Dry Hole Abandoned

Date

SEP 8 1937

19

H. D. Hatfield

Scout