

# KANSAS


FORM 51 5M 4-41 PETROL

Stafford

Section 23 Township 24 Range 13-W

Well No. 5 Benton

Company Cities Service Oil

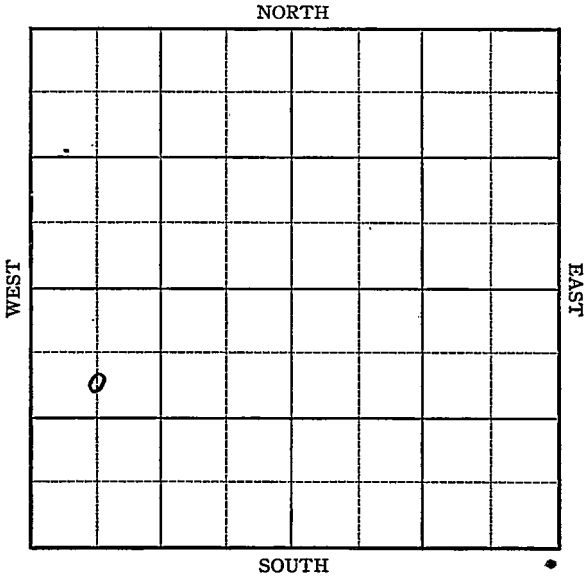

Sec. 23 Twp. 24 R. 13-W

Well No. #5 Benton Farm

Cities Service Oil Company


(McNaghten)

990 Ft. from N. Line

\_\_\_\_\_ Ft. from S. Line

\_\_\_\_\_ Ft. from E. Line

660 Ft. from W. Line

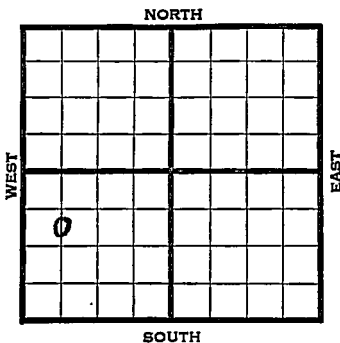

Elev. 1929

1941	REPORT
7/9	Location
7/17	Derrick.
7/24	16" @ 340 Drlg. 1995'
7/31	Drlg. 3780'
8/6	Arb 4129'
	TD 4160'
	No shows.
	ABANDONED

Map No. 83 Sec. 23 Twp. 24 R. 13WWell No. 5 BentonCities Service Oil Company~~FIRST REPORT~~ Contractor

## SECTION PLAT

C S L NW SW

990 Ft. from N. Line

\_\_\_\_\_ Ft. from S. Line

\_\_\_\_\_ Ft. from E. Line

660 Ft. from W. Line


McNAGHTEN POOL

Location X

Rig up \_\_\_\_\_

Drilling and Remarks:

## RECORD

Cased \_\_\_\_\_ in., \_\_\_\_\_ ft.

Sand \_\_\_\_\_

Gas \_\_\_\_\_

Oil \_\_\_\_\_

Total Depth \_\_\_\_\_

## PRODUCTION

1st 24 hrs. Nat. \_\_\_\_\_

1st 24 hrs. after shot \_\_\_\_\_

Gas \_\_\_\_\_ Cu. Ft.

Dry Hole \_\_\_\_\_

Abandoned \_\_\_\_\_

Date

JUL 9 1941 19S. J. LEWIS Scout

Map No. 83 Sec. 23 Twp. 24 R. 13WWell No. 5 BentonCities Service Oil CompanyABANDONED Contractor

## SECTION PLAT

990 C S L NW SW  
Ft. from N. Line

Ft. from S. Line

Ft. from E. Line

660 Ft. from W. Line

o			

ST. JOHN POOL

## RECORD

Location \_\_\_\_\_

Cased \_\_\_\_\_ in., \_\_\_\_\_ ft.

Rig up \_\_\_\_\_

Sand \_\_\_\_\_

Drilling and Remarks:

Gas \_\_\_\_\_

Oil \_\_\_\_\_

Total Depth 460

## PRODUCTION

1st 24 hrs. Nat. \_\_\_\_\_

1st 24 hrs. after shot \_\_\_\_\_

Gas \_\_\_\_\_ Cu. Ft.

Dry Hole \_\_\_\_\_

Abandoned \_\_\_\_\_

*CR 4429*  
*Noshows*

Date

AUG 6 1941 19

S. J. LEWIS Scout