


Map No. 23 Sec. 24 Twp. 13WWell No. #1 Morgan Farm
Lario & Shill Company

NORTH

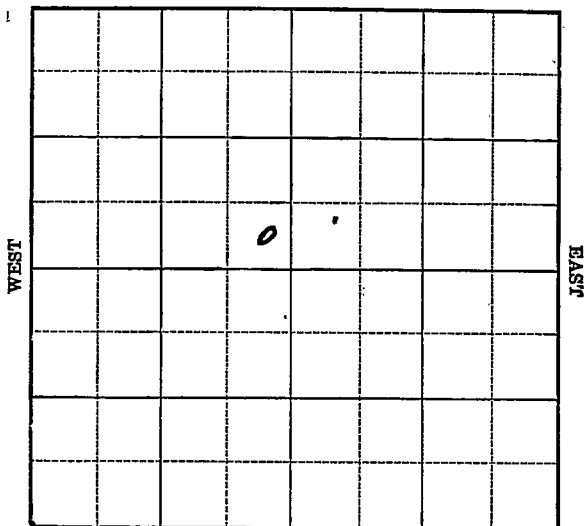

SOUTH

O. W. D. D

Location _____
Drilling Remarks _____Rig Up _____
Drilling Remarks _____

RECORD

Cased _____ in. _____ ft.
Sand _____
Gas _____
Oil _____
Total Depth _____

PRODUCTION


1st 24 hrs. Nat. _____
1st 24 hrs. after shot _____
Gas _____ cu. ft.
Dry Hole _____
Abandoned _____

Stafford

Map No. KANSAS Sec. 23 Twp. 24 R. 13 W

Well No. 1- Morgan Farm
Lario & Elwell Company

 Ft. from N. Line
330 Ft. from S. Line
330 Ft. from E. Line
 Ft. from W. Line

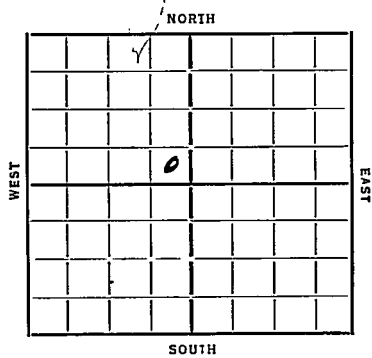

Date 1935

REPORT **O. W. D. D**

<u>2/13</u>	<u>Location</u>	
<u>2/21</u>	<u>Moving In</u>	
<u>2/28</u>	<u>Rd</u>	
<u>3/7</u>	<u>Qty 564</u>	<u>15 1/2 230 -</u>
<u>3/14</u>	<u>" 2295</u>	
<u>3/21</u>	<u>" 3056</u>	
<u>3/28</u>	<u>HC 3543 3508. S.O. 3602 3588-93</u>	
<u>4/4</u>	<u>HC 3508 Corrected 8" 3571--</u>	
	<u>S.O. 3588-93 Rust</u>	
<u>4/8</u>	<u>Drilled plug T7 3597</u>	
	<u>Filled up 800 feet oil 5 hrs.</u>	
	<u>Are now bailing Kansas City</u>	
	<u>line (Telegram)</u>	
<u>4/11</u>	<u>T7 3602 2500 oil 50 hrs</u>	
	<u>Will test</u>	
<u>4/18</u>	<u>P 40 Bbls 8 hrs 30 Prod</u>	
	<u>1500 acid</u>	
<u>4/26</u>	<u>P 342 Bbls 24 hrs.</u>	
<u>5/2</u>	<u>83 Bbls 24 hrs to deepen</u>	
<u>5/9</u>	<u>6" 3596 2500 oil 4 hrs 3625</u>	
<u>5/16</u>	<u>P 368 Bbls 9 hrs.</u>	

(OVER)

5/22 Lansing 3508
T 3628
1000 acid
840 bbls Cut 1%.

COMPLETED

1936 O. W. D. D

9/9- Old total depth 3628'
Moving in tool,

9/18-Rigging up.

9/24-T.D. 3758'. swabb 4 bbls of oil and
8 bbls of water per hour.

10/1-Conglomerate 3810'. Drlg. 3841'.

10/13--Top Siliceous 4075

Pay 4084-87

3000 feet oil in 1 hour

3800 feet total fill up

Swab 54 bbls. per hour for 4 hours

2000 feet off bottom (Tel)

10/15-Dolomite 4075'. T.D. 4087'.

3000' ~~gallons~~ of oil in 1 hour.

Swab 54 bbls per hour for 4 hrs.

2000' off bottom.

10/22-Pump 1100 bbls of oil in 18 hrs.

10/28/36-Sil. 4072'.

T.D. 4087'.

Pump 1258 bbls in 21 hours.

COMPLETED

Map No. 83 Sec 23 Twp. 24 R. 13W
 Well No. Morgan
Lario & Elwell Company

Contractor

FIRST REPORTS

SECTION PLAT

	0		

Ft. from N. Line

330 Ft. from S. Line

330 Ft. from E. Line

Ft. from W. Line

KANSAS

Location ☒

Rig up

Drilling and Remarks:

RECORD

Cased _____ in., _____ ft.

Sand _____

Gas _____

Oil _____

Total Depth _____

PRODUCTION

1st 24 hrs. Nat. _____

1st 24 hrs. after shot _____

Gas _____ Cu. Ft.

Dry Hole _____

Abandoned _____

Date

2-13-30 192

ORVAL MANNSCHRECK

Scout

KANSAS

Map No. 83 Sec. 23 Twp. 24 R. 13WWell No. 1-MorganLario et al Company

Contractor

COMPLETED

SECTION PLAT

Ft. from N. Line

330 Ft. from S. Line330 Ft. from E. Line

Ft. from W. Line

Location

Rig up

Drilling and Remarks:

1000 and
840 bbls
cut 1070

RECORD

Cased _____ in., _____ ft.

Sand laning 3508

Gas _____

Oil _____

Total Depth 3628

PRODUCTION

1st 24 hrs. Nat. _____

1st 24 hrs. after shot _____

Gas _____ Cu. Ft.

Dry Hole _____

Abandoned _____

Date

5-22-35 192

GEORGE MANN SCHRECK

Scout

Map No. 83 Sec. 23 Twp. 24 R. 13WWell No. 1 MorganLavin & Dal Company

Contractor

SECTION PLAT

_____ Ft. from N. Line

330 Ft. from S. Line

_____ Ft. from E. Line

330 Ft. from W. Line

FIRST REPORT

O.W.D.D.Location O.W.D.D.

Rig up _____

Drilling and Remarks:

Old HT 3628Movin in hole

RECORD

Cased _____ in., _____ ft.

Sand _____

Gas _____

Oil _____

Total Depth 3628

PRODUCTION

1st 24 hrs. Nat. _____

1st 24 hrs. after shot _____

Gas _____ Cu. Ft.

Dry Hole _____

Abandoned _____

Date

SEP 9 1936

S. J. LEWIS Scout

KANSAS

Map No. 83 Sec. 28 Twp. 24 R. 13WWell No. 1 MorganCompany Larion

Contractor

SECTION PLAT

 Ft. from N. Line330 Ft. from S. Line330 Ft. from E. Line Ft. from W. Line

COMPLETED

Location Rig up

Drilling and Remarks:

Si'l 4072Pump 12588821 hrs.

RECORD

Cased in., ft.Sand Gas Oil Total Depth 4087

PRODUCTION

1st 24 hrs. Nat. 1st 24 hrs. after shot Gas Cu. Ft.Dry Hole Abandoned

Date

OCT 28 1936S. J. LEWIS

Scout