


KANSAS

Section 23 Township 24 Range 13-W


Well Number 3 Morgan

Company Lario & Atlantic

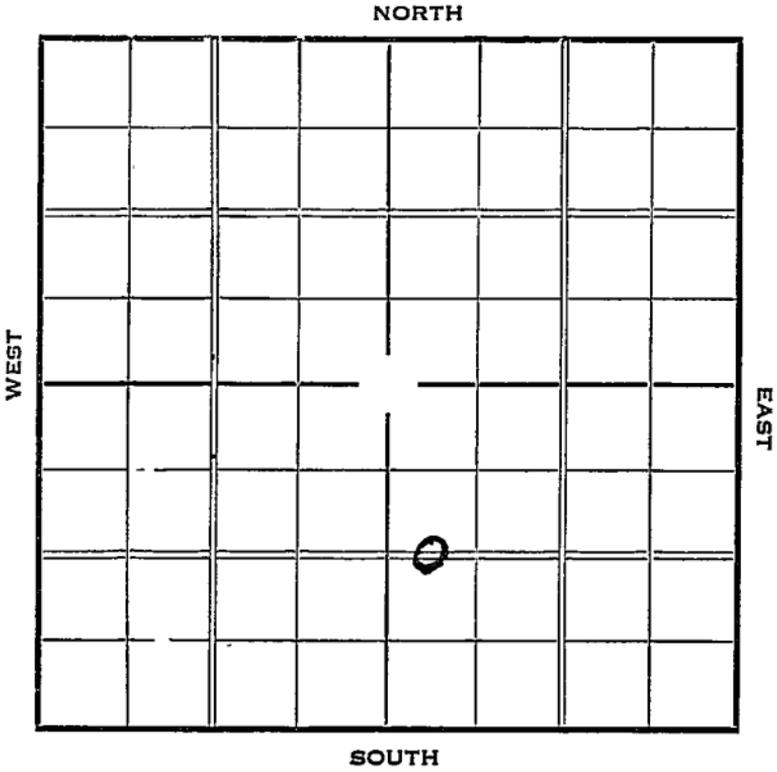

Sec. 23 Twp. 24 R. 13-WWell No. #3 Morgan FarmLario & Atlantic Company Ft. from N. Line1320 Ft. from S. Line Ft. from E. Line330 Ft. from W. Line

Elev. 1920

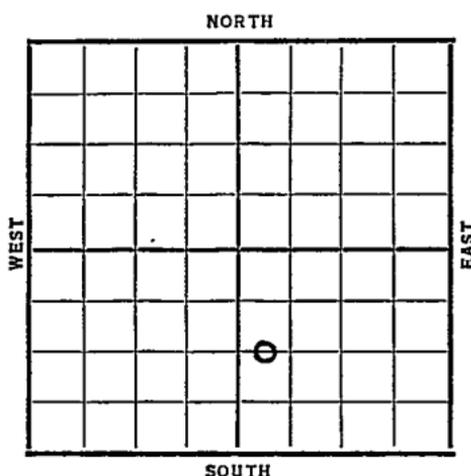

Date	REPORT
1937	
3/24	Surface hole.
4/2	12" @ 255'. Drlg. 2466'.
4/8	Drlg. 3390'
4/16	Simpson 4070'. Drlg. 4105'.
4/23	Sil. 4119' set 7". WOG.
4/30	T.D. 4131'. 2000' oil. 1500' water. Plug back. 4124 WOG.
5/7	T.D. 4131'. Testing.
5/12	7" @ 4119'.
	Sil. 4119'.
	T.D. 4131'.
	Potential 795 bbls. 24 hrs.
	Down 3 hrs.
	COMPLETED

KANSAS *Stopped*

Map No. 83 Sec. 23 Twp. 24 R. 13W.

Well No. 3 Morgan

Lewis & Atlantic Company

Contractor

SECTION PLAT

_____ Ft. from N. Line

1320 Ft. from S. Line

_____ Ft. from E. Line

330 Ft. from W. Line

FIRST REPORT

Location _____

Rig up _____

Drilling and Remarks:

Surface hole

RECORD

Cased _____ in., _____ ft.

Sand _____

Gas _____

Oil _____

Total Depth _____

PRODUCTION

1st 24 hrs. Nat. _____

1st 24 hrs. after shot _____

Gas _____ Cu. Ft.

Dry Hole _____

Abandoned _____

Date

MAR 24 1937

19

S. J. LEWIS Scout

Stafford **KANSAS**

Map No. 83 Sec. 23 Twp. 24 R. 13^W

Well No. 3-Morgan

Lario & Atlantic Company

Contractor

COMPLETED

SECTION PLAT

		0	

 Ft. from N. Line

1320 Ft. from S. Line

 Ft. from E. Line

330 Ft. from W. Line

Location

Rig up

Drilling and Remarks:

POT. - 795/24 hrs
down 3 hrs

RECORD

Cased 7 in., 4119 ft.

Sand Sil - 4119

Gas

Oil

Total Depth 4131

PRODUCTION

1st 24 hrs. Nat.

1st 24 hrs. after shot

Gas Cu. Ft.

Dry Hole

Abandoned

Date

MAY 12 1937

19

H. D. Hatfield

Scout