Form 51-5M-12-36 Com'l


Stafford

KANSAS

Section 23 Township 24 Range 13-W

Well Number 4 Morgan

Company Lario & Atlantic

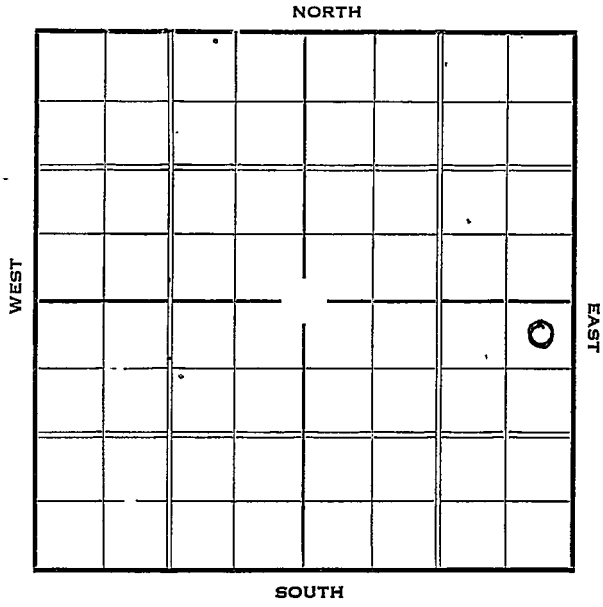

Form 252-A—5M—2-37—Palace KANSAS Stafford

Sec. 23 Twp. 24 R. 13-W

Well No. #4 Morgan Farm

Lario & Atlantic Company


330 Ft. from N. Line

Ft. from S. Line

330 Ft. from E. Line

Ft. from W. Line

Elev. 1909

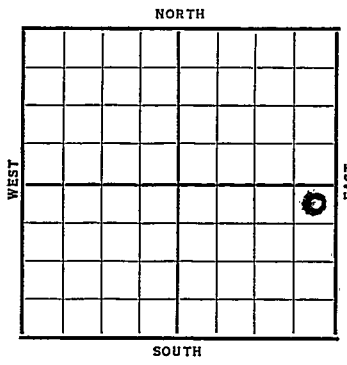

Date	REPORT
1937	
4/14	Location
4/23	Rig
4/30	12" @ 253'. Drlg. 2000'.
5/7	Drlg. 3110'.
5/14	Drlg. 3943'.
5/21	Sil. 4095-97'.
	7" @ 4095'. Drlg. plug.
5/26	7" @ 4095'.
	Sil. 4102'. (Corrected)
	T.D. 4111'.
	H.F.W. 4102 1909 2193
	ABANDONED

Form 26—1M Bks.—2-29 KANSAS Stafford


Map No. Sec. 23 Twp. 24 R. 13W

Well No. 4 Morgan

Lario & Atlantic Company

Contractor

SECTION PLAT

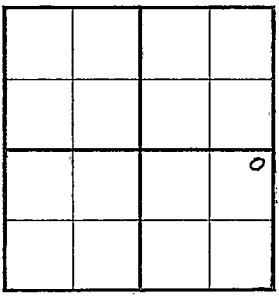

330 Ft. from N. Line

Ft. from S. Line

330 Ft. from E. Line

Ft. from W. Line

FIRST REPORT

Location ✓

Rig up

Drilling and Remarks:

RECORD

Cased in., ft.

Sand

Gas

Oil

Total Depth

PRODUCTION

1st 24 hrs. Nat.

1st 24 hrs. after shot

Gas Cu. Ft.

Dry Hole

Abandoned

Date

APR 14 1937 19

S. J. LEWIS Scout

Form 26—1M Bks.—2-29 Stafford KANSAS

Map No. Sec. 23 Twp. 24 R. 13 W

Well No. 4 - Morgan

Lario & Atlantic Company

Contractor

ABANDONED

ABANDONED


330 Ft. from N. Line

Ft. from S. Line

330 Ft. from E. Line

Ft. from W. Line

SECTION PLAT

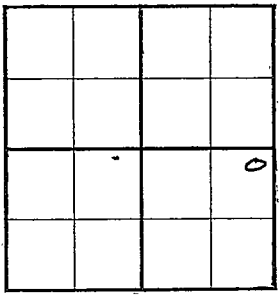

Location

Rig up

Drilling and Remarks:

H.F.W.,

D & A

RECORD

Cased 7 in., 4095 ft.

~~Sand~~ Sil 4102

Gas (corrected)

Oil

Total Depth 4111

PRODUCTION

1st 24 hrs. Nat.

1st 24 hrs. after shot

Gas Cu. Ft.

Dry Hole

Abandoned

Date

MAY 26 1937 19

H. D. Hatfield Scout