


Form 51--5M--7-40--Palace

Section 23 Township 24 Range 13-W

Well No. 2-Tudor

Company Stanolind & Lario

NORTH McNaghten Pool

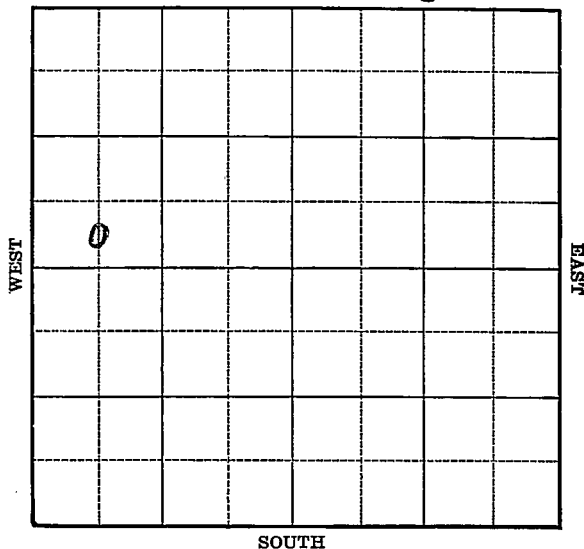


KANSAS

Stafford

Sec. 23 Twp. 24 R. 13-WWell No. #2 Tudor FarmStanolind & Lario Company
(McNaghten.) Ft. from N. Line330 Ft. from S. Line Ft. from E. Line660 Ft. from W. Line

Elev. 1924

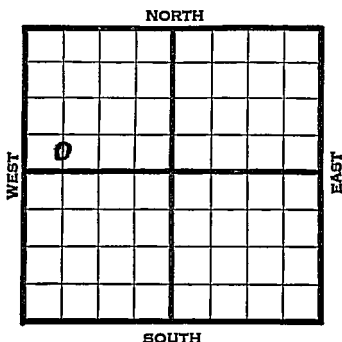

1941	REPORT
4/2	Location
4/10	"
4/18	"
4/24	"
5/1	"
5/8	"
5/15	8" - 239' Drlg. 450'
5/22	Drlg. 3422'
5/28	Lens. 3590' Viola 3935'
	Drlg. 4095'
6/5	Arb. 4097-4110' T.D. 5" - 4098'
	RUST.
6/12	"
6/18	Arb. 4097'
	5" - 4098'
	T.D. 4110'
	300 acid.
	Depthograph potential 8162 bbls.
	Maximum 3000 bbls.
	38. Gravity
	COMPLETED

Map No. 83 Sec. 23 Twp. 24 R. 13WWell No. 2 TudorStanolind & Lario Company**FIRST REPORT** Contractor

C S L SW NW

 Ft. from N. Line330 Ft. from S. Line Ft. from E. Line660 Ft. from W. Line

McNAGHTEN POOL

SECTION PLAT

o			
	.		

Location XRig up

Drilling and Remarks:

RECORDCased in., ft.Sand Gas Oil Total Depth **PRODUCTION**1st 24 hrs. Nat. 1st 24 hrs. after shot Gas Cu. Ft.Dry Hole Abandoned

Date

APR 2 1941 19 S. J. LEWIS Scout

Map No. 83 Sec. 23 Twp. 24 R. 13WWell No. 2 Tudor

Contractor

COMPLETED

C S L SW NW

SECTION PLAT

Ft. from N. Line

330 Ft. from S. Line

Ft. from E. Line

660 Ft. from W. Line

McNAGHTEN POOL

Location

Rig up

Drilling and Remarks:

*See 4097**5" @ 4098**300 acid**Sept 28 8/62**Net 3000**382 hr*

RECORD

Cased _____ in., _____ ft.

Sand _____

Gas _____

Oil _____

Total Depth 4110

PRODUCTION

1st 24 hrs. Nat. _____

1st 24 hrs. after shot _____

Gas _____ Cu. Ft.

Dry Hole _____

Abandoned _____

Date

JUN 18 1941

19

S. J. LEWIS Scout