


Section 23 Township 24 Range 11W

Well No. #3 Koelsch

Company Harry Gore

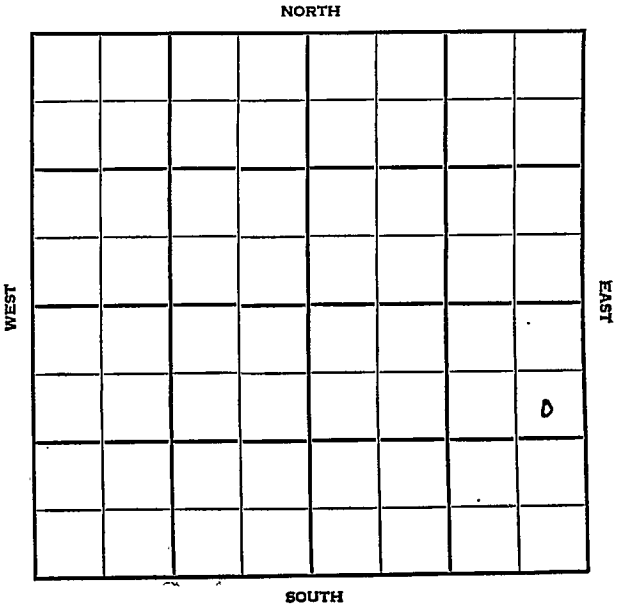

Stafford

KANSAS

SEC.	TWP.	R.
23	24	14 W ✓

WELL NO.

3 Koelsch

FARM

COMPANY

Harry Gore

CONTRACTOR

Veeder

Koelsch Pool


990 Ft. from N. Line

Ft. from S. Line

330 Ft. from E. Line

Ft. from W. Line

SE NE SE

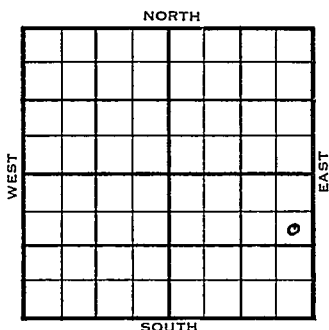

ELEVATION

REPORT

1954

1932

5/12

Spud 5-8-54
8" @ 361 Drlg. 2010'

5/19

Anhy 817', Heeb 3449', Br. L. 3583'
Lans 3609'

DST 3830'-46' 1 hr, 40' HOCM, 140' MCO
860#

Drlg 3773'

5/26

DST 3770-96', 1 hr., 38' wtr, 965#
20"

RTD 3796'

5" @ 3795'

42/3736-43

FU 125' oil 1 hr.

6/2

3000A

P/5 BOPH + trace 24 hrs.

~~12/7~~

Spudding 5-8-54

Oil well

TD 3796

8" @ 361

Amy 817 Heeb 3449 Br. lime 3583

Lans. 3609

DST 3730-46 open 1 hr. Rec. 40' hocm

140' mco 860# DST 3770-96 open 1 hr.

Rec 38' wtr. 965#

TD 3796

5" @ 3795 42/ 3736-43 FU 125' oil


OVER

1954
- 12/7 3000 A P / 5 boph Comp. 193 bopd

COMPLETED

J. G. McGEHEE

County Stafford State Kansas
 Sec. 23 (Blk.) 24 (Sur.) 14W Map No.
 Operator Harry Gore
 Well No. 3 Farm Koelsch
 Elev. 1932 Location SE NE SE

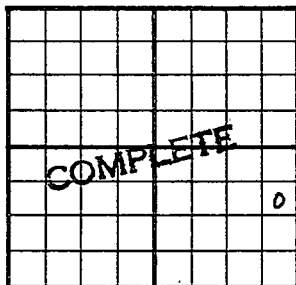

990 Ft. From N Line SE
330 Ft. From E Line Quarter
 Ist. Report
 Completion JUL 7 1954
 Remarks Koelsch Pool
Veeder - Contr.
 Spudding Date 5-8-54

Drilg. Data Oil well TD 3796
8" @ 361 Anhy 817 Heeb. 3449
Br. lime 3583 Lans. 3609 DST 3730-46
open 1 hr. Rec. 40' hocm 140' mco
860# DST 3770-96 open 1 hr. Rec.
38' wtr. 965# TD 3796 5" @ 3795
42/ 3736-43 FU 125' oil 1 hr. 3000 A
P/ 5 bopd Comp. 193 bopd

J. G. McGEHEE