

Finney


KANSAS

SECTION 23 TOWNSHIP 24 RANGE 32W

WELL NO. #1 Wolf Gas Unit

COMPANY Stanolind

NORTH

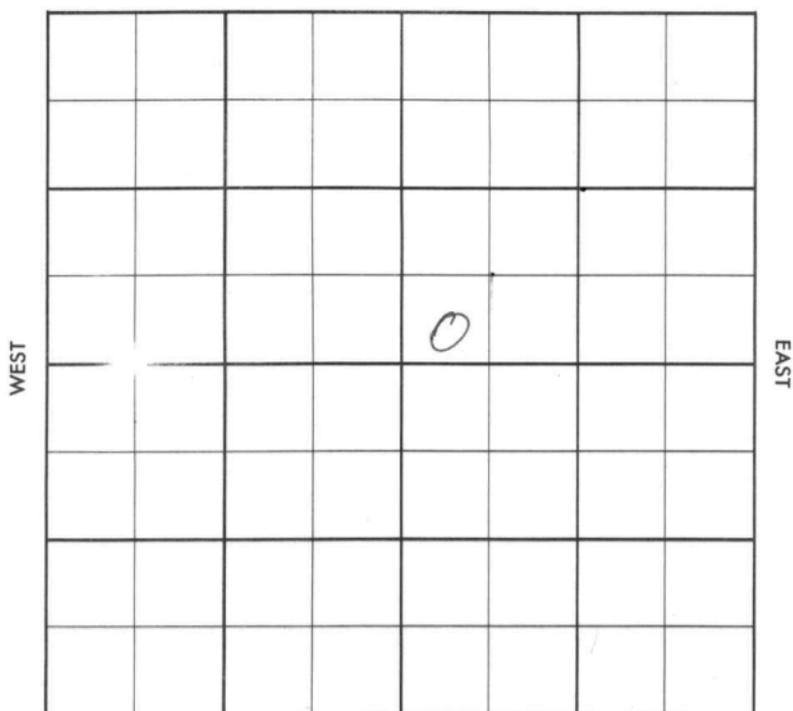

SOUTH

County Minney Elev. _____
 Sec. 23 Twp. 24 Rge. 3 2W
 Company Stanolind
 Farm Name Wolf Gas Unit No. 1

TOPS	DEPTH	LOG	DATUM	Loc. in Sec.
Anh.				SW SW NE
Tr.				150' SL
H.				150' WL
Tr.				
Dg.				
Bl.				
L.				Geol. _____
K.C.				Contr. _____
B.K.C.				Noble Drlg.
Ce.				
C.				
M.				Pool
M.				Hugoton
K.				
Mz.				
Me.				
V.				
S.				
S.				
A				
R.				
Pe.				
G.				
T.D.				

FIRST REPORT
 0
 DEC 12 '55

Date Comm. _____
 Location _____

~~35~~

Co.

Lse.

R.

County Finney Elev. ? 2806 Brd.
 Sec. 23 Twp. 24 Rge. 32W
 Company Stanolind
 Farm Name Wolf Gas Unit No. 1

TOPS	DEPTH	LOG	DATUM	Loc. in Sec.
Anh <u>Heir</u>	<u>2516</u>			SW SW NE
TP <u>KFI</u>	<u>2546</u>			
H.				150' SL
Tr.				
Dg.				150' WL
Bl.				
L.				Geol.
K.C.				Contr.
B.K.C.				Noble Drlg.
Ce.				
C.				Pool
M.				Hugoton
M.				
K.				
Mz.				
Ma.				
V.				
S.				
S.				
A.				
R.				
PC.				
G.				
TD.	<u>2557</u>			

COMPLETE
 •
 JAN 9 57

Date Comm.

Location DEC 19 '56 12-15-56 8³/₈1054/600 ID 1056 DEC 26 '56 5¹/₂

2552/1000 WOCT JAN 2 '57 CO 2543

72/2524-36 F180 9a 4.55 MCF

9a 3, 961 MCF. 5.1. JAN 9 '57 24-20

9a 9, 350 MCF 51P 402#